

96

For Narrative, see Volume 1, Page 78

99

E 6th St.

280.0 (Recor.)
280.32 (1st 11)

N 54°55'30"E 120.16

DR 265-321

N 15°07'30"W 90.22

S 71°07'20"E 90.28

S 54°57'10"W 120

4 3 2 1

9 8 7 6 5

13

N CENTRAL AVE

BARTLETT ST

MAIN (7th) ST.



LOT SURVEY

for

ROBT. KEENEY

located in



Block 13 Medford (Orig. Town)
(Newberry Bldg)

Scale 1"=60'

Sept. 24, 1948

J.H. Clabby

Consulting Engr

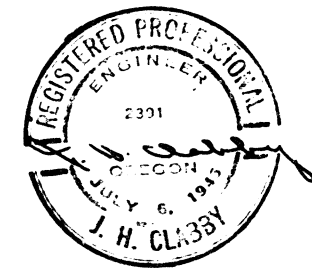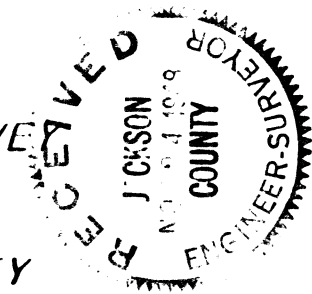

Survey For: Robert Keeney (Newberry Building Lot)
Described in Deed Record 365, page 321
Jackson County Court House, Madford, Oregon.

Purpose of Survey: To locate corners and boundaries of tract described in Deed Record 265, page 321.

Survey Procedure: Located intersection monuments at East 6th Street and Central Avenue and at East 6th. Street and Bartlett Street. Measured the distance between these points and found the proportioned distance in the description to check exactly. Then proceeded to locate corners of lot according to Description. Found lead plug in sidewalk at Northeast corner of lot and found nail and plug in concrete wall to mark Southeast corner of lot. Checked Northeast corner exactly. Checked Southeast corner exactly for distance from 6th. Street, but our line hit 0.01 feet East of established point. Northeast corner of lot overlaps 0.10 feet on next building. Southeast corner of lot overlaps 0.04 feet on next building.

September 1948

J. H. Clabby

