

LOT SURVEY

FOR


Mr. GEO. FIELDS

Lots 7 & 8, Block 6, Medford (Orig Town)

Scale: 1" = 60'

October 30, 1948

J.H. CLABBY  
Consulting Engr.

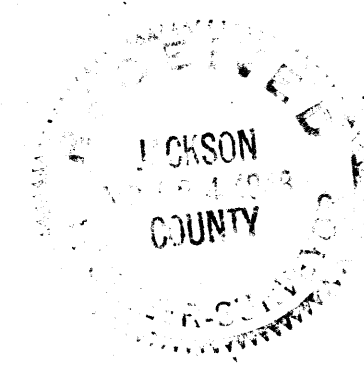

100

Note: All lots are 50' x 100' according to plat.  
Proportioned distances shown on lots staked

## 100 Survey Narrative to Comply with Section 87, 330 - Oregon State Laws.

Survey for: Mr. George Fields  
Lots 7 and 8, Block 6, Original Town of Medford, Oregon.

Purpose of Survey: To establish the boundaries and four outside corners of lots 7 and 8.

Survey Procedure: Located center line intersection monuments at North Bartlett and East 3rd. and East 4th Streets, and at Apple Street and East 3rd. and East 4th. Streets. Measured distances along center lines and measured angles around complete block.

Angles and distances shown on accompanying plat. Proceeded to stake lots parallel to North Bartlett Street and East 3rd. Street center lines. Proportioned distances shown on accompanying plat.

Found picket fence on Northwesterly line of Lot 9 overlaps on Lot 8 as shown on accompanying plat.

J. H. Clabby

October 1948

