


U.S. VETERANS ADMINISTRATION

HOSPITAL TRACT

SECS. 16 & 17, T36S. R1W, W.M.

NOV. 1948

107

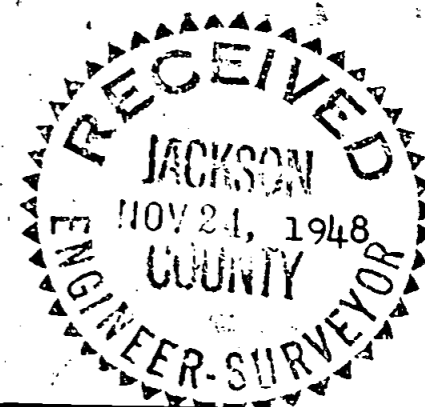

REGISTERED
OREGON
LAND SURVEYOR

C. E. Boyden

MARCH 10, 1944
C. E. BOYDEN
7

WHITE CITY

N44°52'15"E 2844.15

459.16

511.0

510.93

N77°31'45"E 510.45
TO SEC. COR.

MARCH 10, 1944
C. E. BOYDEN
7

N0°12'E 1619.60
18TH ST.

AVE. N

511.0

N89°48'W 1341.30
AVE. G

22'
AVE. J

22'

AVE. L

S45°08'15"E 2092.05

ARMY ENG'S MONUMENT
3" BRASS DISC IN CONCRETE
SCALE 1" = 400'

S44°27'45"W 5837.55
TO 1/4 COR. SECS. 19 & 20

HOSPITAL ROAD

S44°51'45"W 3053.15

511.0

155.15

CRATER-LAKE-HWY. PAVING

56144

Sec 16 & 17 T. 36 S. R. 1 W.

Survey No. 107 for U. S. Veterans Administration.

Purpose of Survey: To establish and monument the boundary of the U. S. Veterans Administration Hospital tract at Camp White in Jackson County, Oregon

Established the center line of the ^{paving} Crater Lake State Highway No. 62 from existing highway monuments. Then established the Northwesterly right of way line 144.0 feet from center line.

Established a line 30.0 feet Westerly at right angle to the center line of 18th Street from U. S. Army Engineer's monuments.

Established a line 50.0 feet Northerly at right angle to the center line of Avenue G from Army Engineer's monuments and produced this line from an intersection with the Northwesterly right of way of the Crater Lake Highway to an intersection with the established line 30.0 feet Westerly from 18th Street.

Established lines 511.0 feet Northwesterly at right angle to the center line of Avenue N and 511.0 feet Northeasterly at right angle to the center line of Avenue L and produced these lines from their intersection Southwesterly to an intersection of the established line 30.0 feet Westerly from 18th Street and Southwesterly to an intersection with the said Northwesterly right of way line of the Crater Lake Highway, thus inclosing a tract of land as required.

A traverse between these intersection points with ties to Government corners is as follows:

Beginning at the section corner to Sections 8, 9, 16, and 17, Township 36 South, Range 1 West, W.M., Jackson County, Oregon; thence S. 77° 31' 45" W. 510.45 feet to the Northerly corner; thence S. 45° 08' 15" E. 2092.05 feet to the Easterly corner; thence S. 44° 51' 45" W. 3053.15 feet to the Southerly corner; thence N. 89° 48' W. 1341.3 feet to the Southwesterly corner; thence N. 0° 12' E. 1619.60 feet to the Westerly corner; thence N. 44° 52' 15" E. 2844.15 to the above mentioned Northerly corner. A traverse from the 1/4 section corner to Sections 19 and 20, Township 36 South, Range 1 West, to the Southerly corner of said tract indicated a course of N. 44° 27' 45" E. and a distance of 5837.55 feet.

At the five corners of the above described tract, set concrete monuments with a 3" brass disc stamped "U.S. Veterans Administration Boundary Monument 1948". Also surveyor's registration number (No. 7).

C. Z. Boyden

Oct 1948

REGISTERED
OREGON
LAND SURVEYOR

C. Z. Boyden

MARCH 10, 1944
C. Z. BOYDEN
7

