

MAY HANLEY
 W. 4TH. ST. MEDFORD OREGON
 SURVEYED MAR 28, 1949

168

REGISTERED
 OREGON
 LAND SURVEYOR

C. Z. Boyden

MARCH 10, 1944
 C. Z. BOYDEN
 7

CONC. MON.

COLUMBUS-AVE.

I.P. MON.

W. MAIN ST.

4TH ST.

N89°42'15"E

428.65

30'

205.35

N0°00'30"E

N0°00'30"E

100.0

61.0

S89°42'15"W

61.0

S0°00'30"W


100.0

S0°00'30"W

MYERS COURT

N

SCALE ÷ 1" = 100'
 • 1/2" PIPE

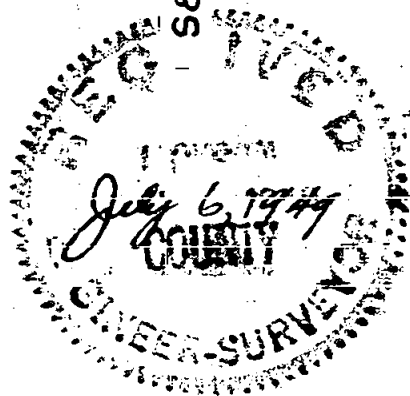

Meiford

Survey No. 168

For: May Hanley

Purpose: To survey property described in Jackson County Deed Records Volume 250, Page 25.

From a concrete monument with copper center point at the intersection of the center lines of Columbus Avenue and West 4th Street, ran N. 89° 42' 15" E. along the center line of 4th Street 30.0 feet; thence S. 0° 00' 30" W. parallel to Columbus Avenue 30.0 feet to the intersection of the south boundary of 4th Street with the east boundary of Columbus Avenue; ran thence N. 89° 42' 15" E. along the south boundary of 4th Street 205.35 feet to the N.W. corner of the property to be surveyed; thence S. 0° 00' 30" W. parallel to Columbus Avenue and Myers Court 100.0 feet to the S.W. corner; then from the above mentioned N.W. corner, ran N. 89° 42' 15" E. along the south boundary of 4th Street 61.0 feet to the N.E. corner; thence S. 0° 00' 30" W. 100.0 feet to the S.E. corner and checked 61.00 feet to the S.W. corner. Iron pipes stamped with No. 7 set for corners.

March, 1949

REGISTERED
OREGON
LAND SURVEYOR

C. Z. Boyden

MARCH 10, 1944
C. Z. BOYDEN
7

