


184

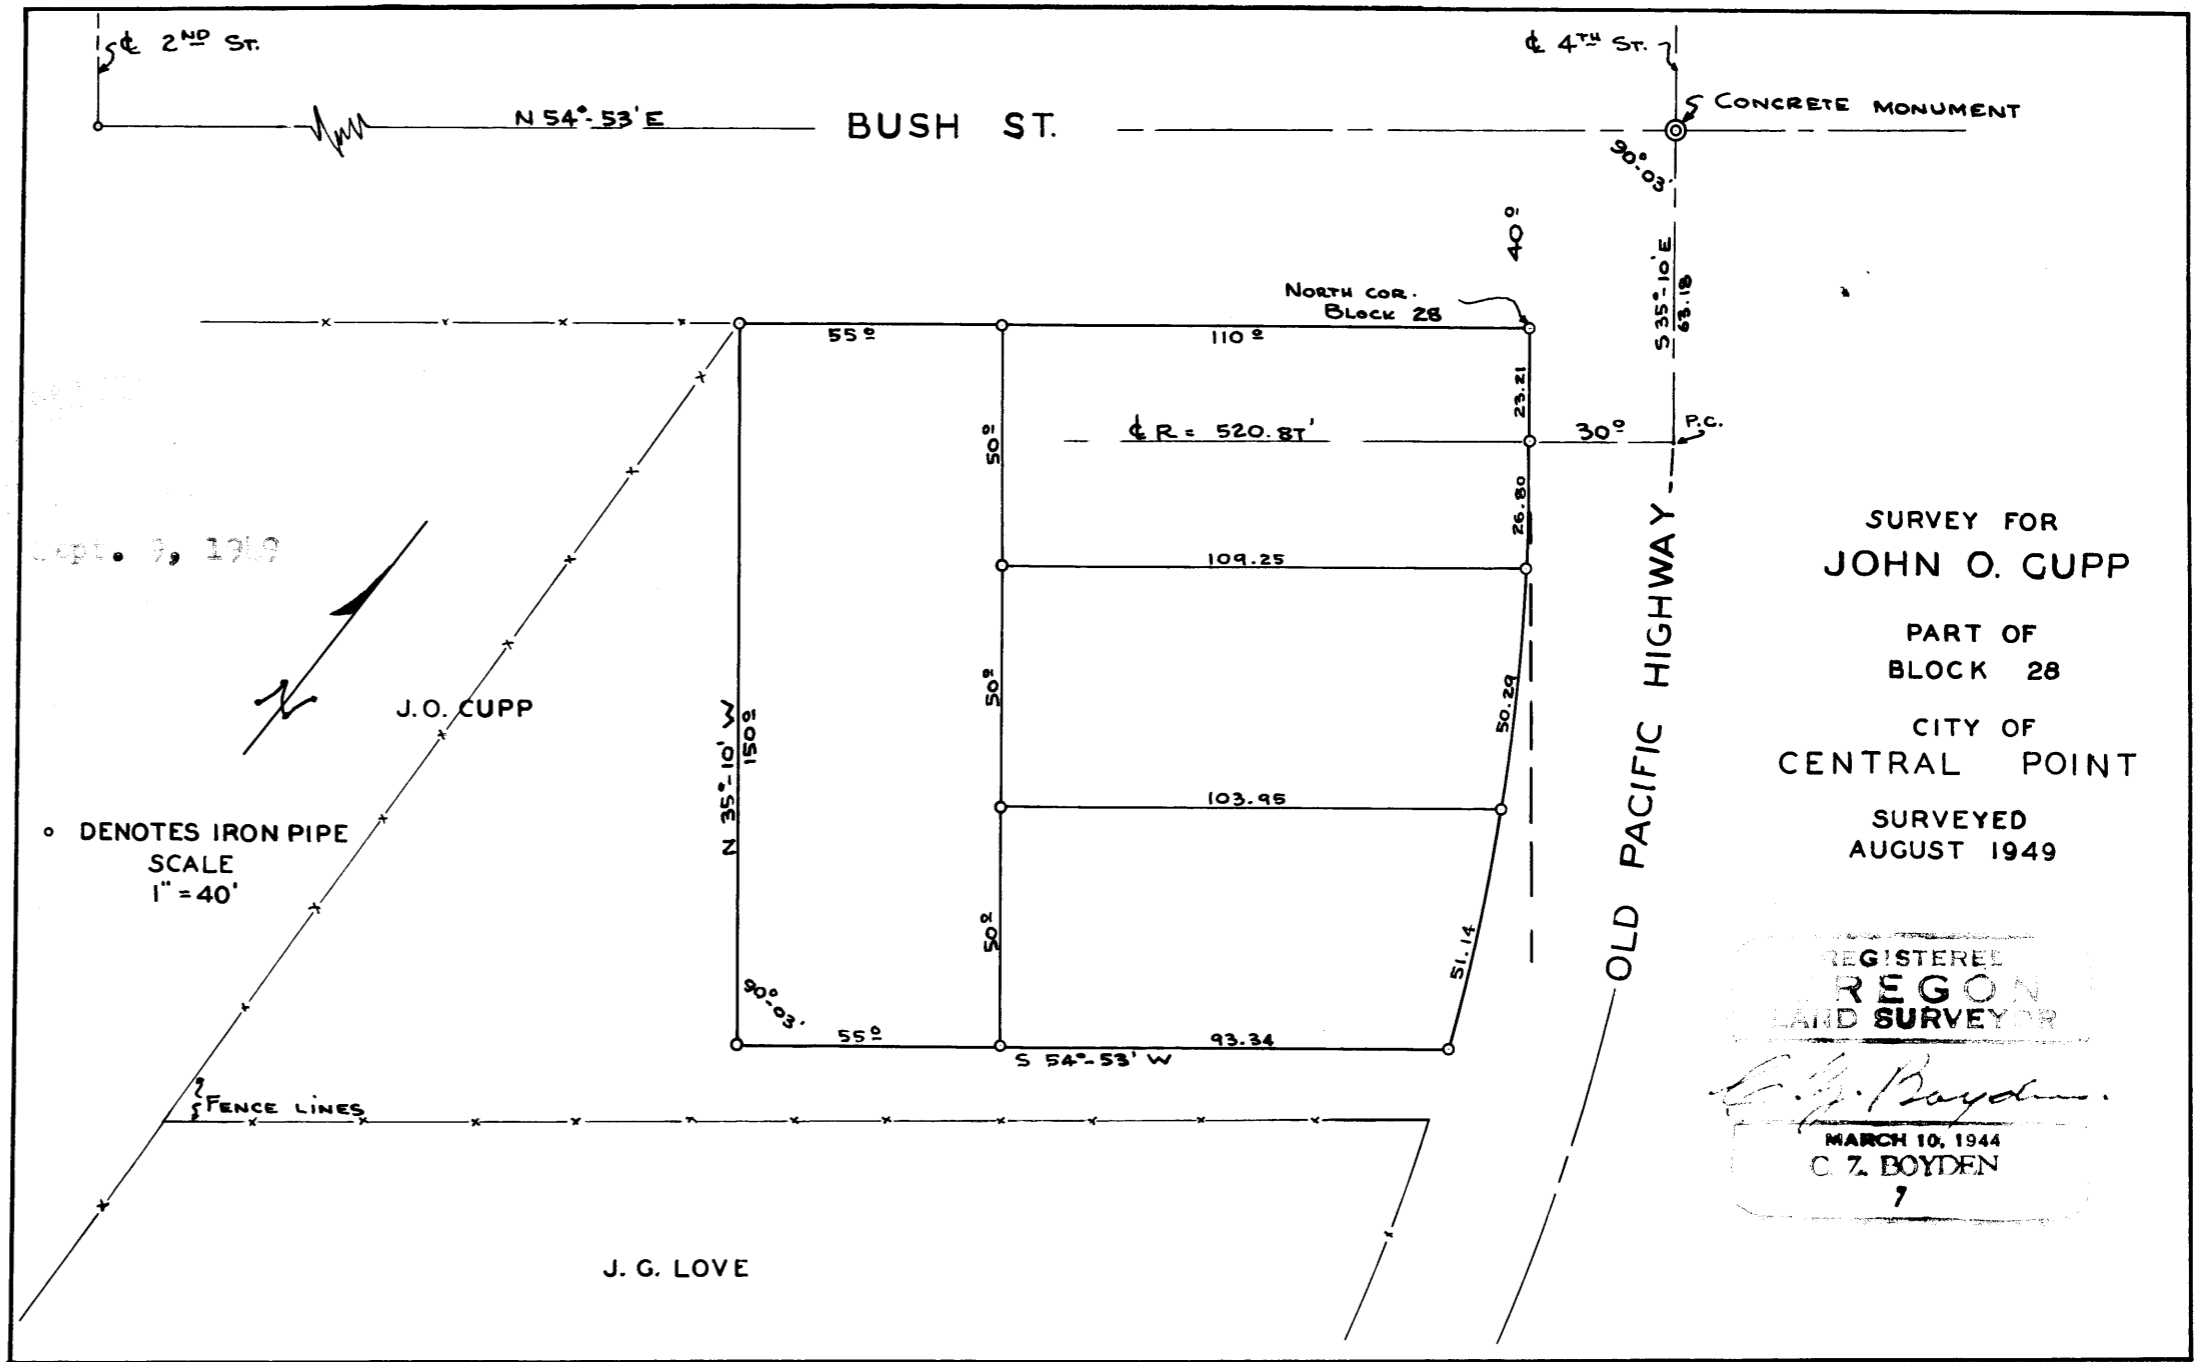

SURVEY FOR
JOHN O. CUPP
 PART OF
 BLOCK 28
 CITY OF
 CENTRAL POINT
 SURVEYED
 AUGUST 1949

REGISTERED
REGON
 LAND SURVEYOR
C. Z. Boyden
 MARCH 10, 1944
 C. Z. BOYDEN
 7

OLD PACIFIC HIGHWAY

184

Survey No. _____ Recorded in the County Surveyor's Office

For: John O. Cupp

Purpose: To establish the boundary lines of four tracts of land as directed in a portion of Block 28 in the City of Central Point, Jackson County, Oregon.

Procedure:

The control for this survey was based upon the location of the centerlines of Fourth Street, Bush Street and the Old Pacific Highway in the City of Central Point. Fourth Street was determined by using the existing concrete monuments at the intersections of Fourth Street centerline with the centerlines of Pine and Bush Streets. Bush Street was determined using the concrete monument at Fourth and Bush Street centerlines and an iron pipe set at the centerline intersection of Second Street with Bush Street. This iron pipe was set using the centerline of Second Street as determined by existing concrete monuments along Second Street, and using a record distance southerly based on the 1910 monument survey for Central Point from the existing concrete monument at the intersection of Cedar and Second Street centerlines. The Old Pacific Highway centerline was determined as it exists on the ground. Beginning at the monument at the centerline intersection of Fourth and Bush Streets, the said tracts were located and monumented with iron pipes, as shown on the plat to accompany this report. All pipes were stamped near the top with a No. "7".

Surveyed: August - 1949

C. Z. Boyden

REGISTERED
 OREGON
 LAND SURVEYOR

C. Z. Boyden

MARCH 10, 1944
 C. Z. BOYDEN
 7

SEP 9 1949
 COUNTY
 ENGINEER-SURVEYOR