

FOUND 1/2" IRON PIN

HOUSTON ROAD


SE COR. DLC. #45

SURVED FOR
 R.H. WILCOX
 SECTION 17 T 38S RI W
 AUGUST
 1949


REGISTERED
 OREGON
 LAND SURVEYOR
G. Z. Boyden
 MARCH 10, 1944
 G. Z. BOYDEN
 7

SCALE:
1" = 100'

• MONUMENT SET

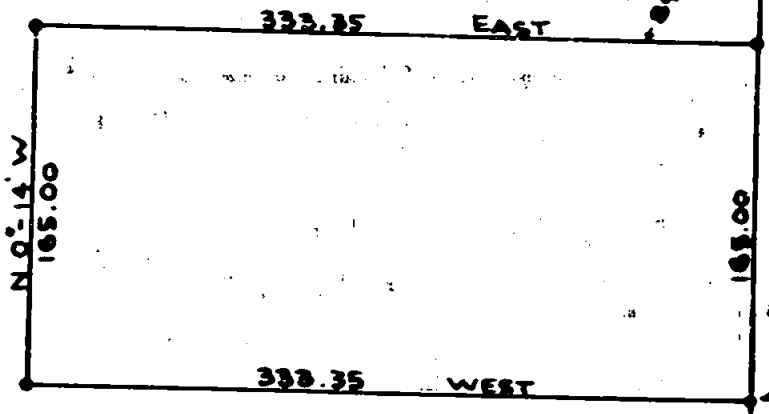

POINT OF BEGINNING
 SOUTH 2190.54'
 WEST 769.9'
 FROM SE COR. DLC. #45

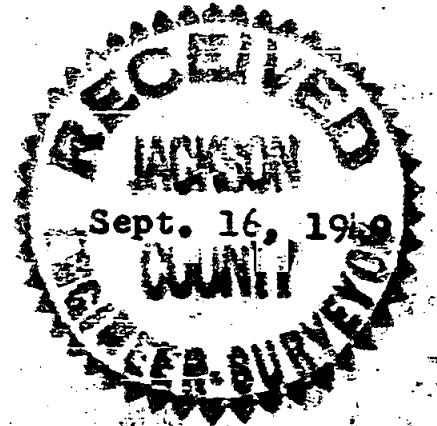

FOUND 1/2" IRON PIPE

90°-14' E
COLEMAN-CREEK-ROAD

Sec. 17

Survey No. 187 Recorded in the County Surveyor's Office

For: R. H. Wilcox

Purpose: To establish the boundary lines of a tract of land as directed, being part of tract described in Jackson County Deed Records, Volume 243, Page 17.

Prodedure:

Found a $1\frac{1}{2}$ " galvanized iron pipe for the southeast corner of Donation Land Claim No. 45, Township 38 South, Range 1 West, as shown in the official record of re-established corners. From said corner ran North $89^{\circ}-36'$ West 753.85 feet to an iron pin which was the centerline intersection of Coleman Creek Road with Houston Road as set by Jackson County in the Road Survey of 1940. From said pin, using the iron pipe at the centerline intersection of Coleman Creek Road with the Fort Baker Road as set in said County Road survey as the established centerline of Coleman Creek Road, ran South $0^{\circ}-14'$ East along the centerline of Coleman Creek Road to a point 2190.54 feet south of said Donation Land Claim corner which was the records distance to the south boundary of the R. H. and Marjorie Wilcox property. Thence ran west to the westerly right-of-way line of the Coleman Creek Road to the point of beginning. From thence ran the lines of the tract and set iron pipe and pin monuments as shown on the plat to accompany this report. All monuments were stamped with No. "7".

August - 1949

C. Z. Boyden



C. Z. Boyden

