

SURVEY FOR
ROBERT A. HUBBARD
SEC. 27 T37SR2W

FOUND 1 1/2" IRON PIPE

1" IRON PIPE
WNW COR.
DLC # 71

SCALE: 1" = 100'



o 1 1/2" IRON PIPE

OCT. 1949

REGISTERED
OREGON
LAND SURVEYOR

C. Z. Boyden

MARCH 10, 1944
C. Z. BOYDEN
7

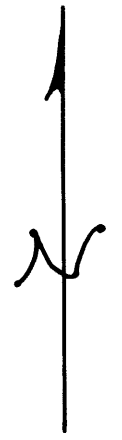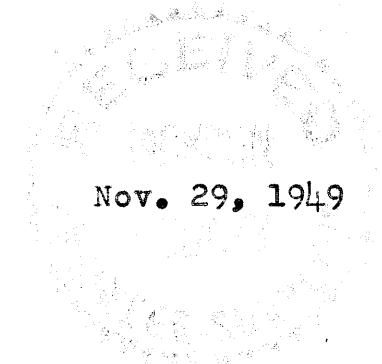

N 89°-30'-30" E 450.00'

N 4°-48' W 500.00'

20'
500.00'
S 4°-48' E
Lane

1" IRON PIPE
SW COR. DLC # 71

FOUND 1 1/2" IRON PIPE

FOUND 1 1/2" IRON PIPE

N 88°-53' E 325.0'

N 89°-30'-30" E 2039.65'

S 89°-30'-30" W 450.00'

30
30

30
30

MEDFORD - PROVOLT HIGHWAY

Survey No. 208

For: Robert A. Hubbard

Purpose: To survey and monument the tract of land described in Volume 321, Pages 368-9, Deed Records, Jackson County, Oregon.

Procedure:

Commencing at a 1" iron pipe on the centerline of the Medford-Provolt Highway, which is the Southwest corner of D.L.C. No. 71, Township 37 South, Range 2 West, and ran North 88°-53' East, 325.0 feet along said centerline to an angle point;

Thence continued along said centerline North 89°-30'-30" East, 2039.65 feet;

Thence ran North 0°-29'-30" West, 30.0 feet to a 1½" galvanized iron pipe to the point of beginning of said Deed Record 321, Pages 368-9;

Thence ran around said tract as described, using 1½" galvanized iron pipes stamped with No. "7" for corner manuments.

October - 1949

REGISTERED
OREGON
LAND SURVEYOR

C. Z. Boyden

MARCH 10, 1944
C. Z. BOYDEN
7















