

SURVEY FOR
 SETTERGREN & WILEY CO.
 LOT 4, BLOCK 63, CITY OF
 CENTRAL POINT - ORE.
 FEB. 1950.


● CONC. MON.
 ○ IRON PIPE

SCALE:
 1" = 60'

N 54° 50' 45" E 280²²

CHERRY ST.

4TH ST.

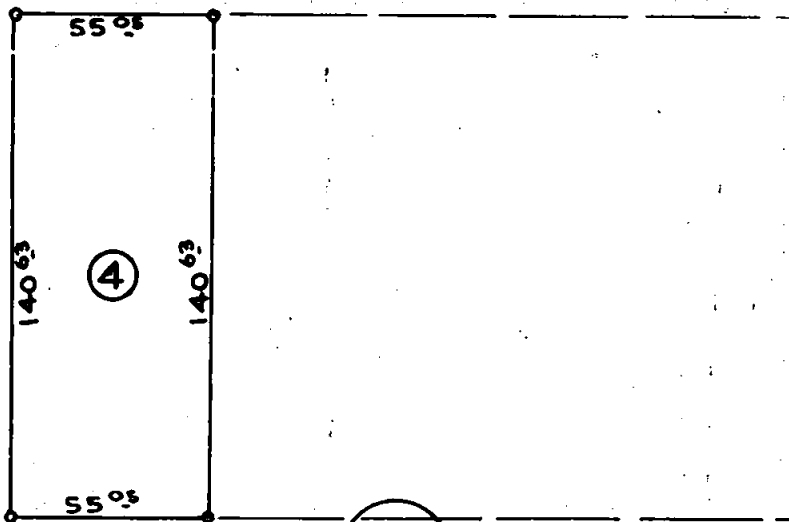

381²⁵ ST.


381²⁵ ST.

N 35° 10' W
 2ND ST.

N 35° 09' 30" W
 3RD ST.

N 54° 50' 45" E 280¹⁹

MAPLE ST.

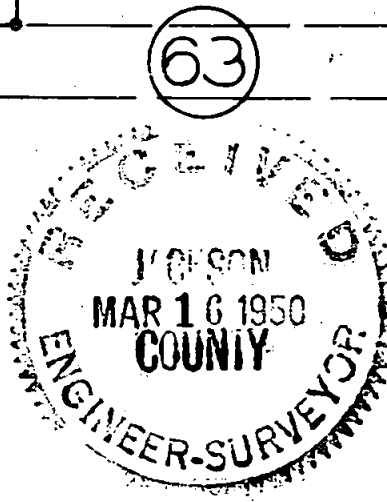

REGISTERED
 OREGON
 LAND SURVEYOR

C. Z. Boyden

MARCH 10 1944
 C. Z. BOYDEN
 7

LAUREL

MANZANITA

219

Survey No. 219

For: W. W. Wiley

Purpose of Survey: To establish the boundaries of Lot No. 4 of Block No. 63 of the original town of Central Point.

Using the existing centerline street monuments as indicated on the map to accompany this report, established the street intersections at the four corners of said Block 63, and determined the length of all boundaries of said Block and then established the boundaries of said Lot No. 4 on a proportional basis determined by the ratio between record and measured distances. Iron pipes were set at the four corners of said Lot.

February - 1950

REGISTERED
OREGON
LAND SURVEYOR

C. Z. Boyden

MARCH 10, 1944
C. Z. BOYDEN
7

ENGINEER-SURVEYOR
OREGON
MAR 16 1950
COUNTY