


L.D. LA FORCE
LOT NO. 3, BLK. NO 41.
ORIG TOWN OF CENTRAL
POINT, ORE.

MARCH 1950

REGISTERED
OREGON
LAND SURVEYOR

C. Z. Boyden

MARCH 10, 1844
C. Z. BOYDEN
7

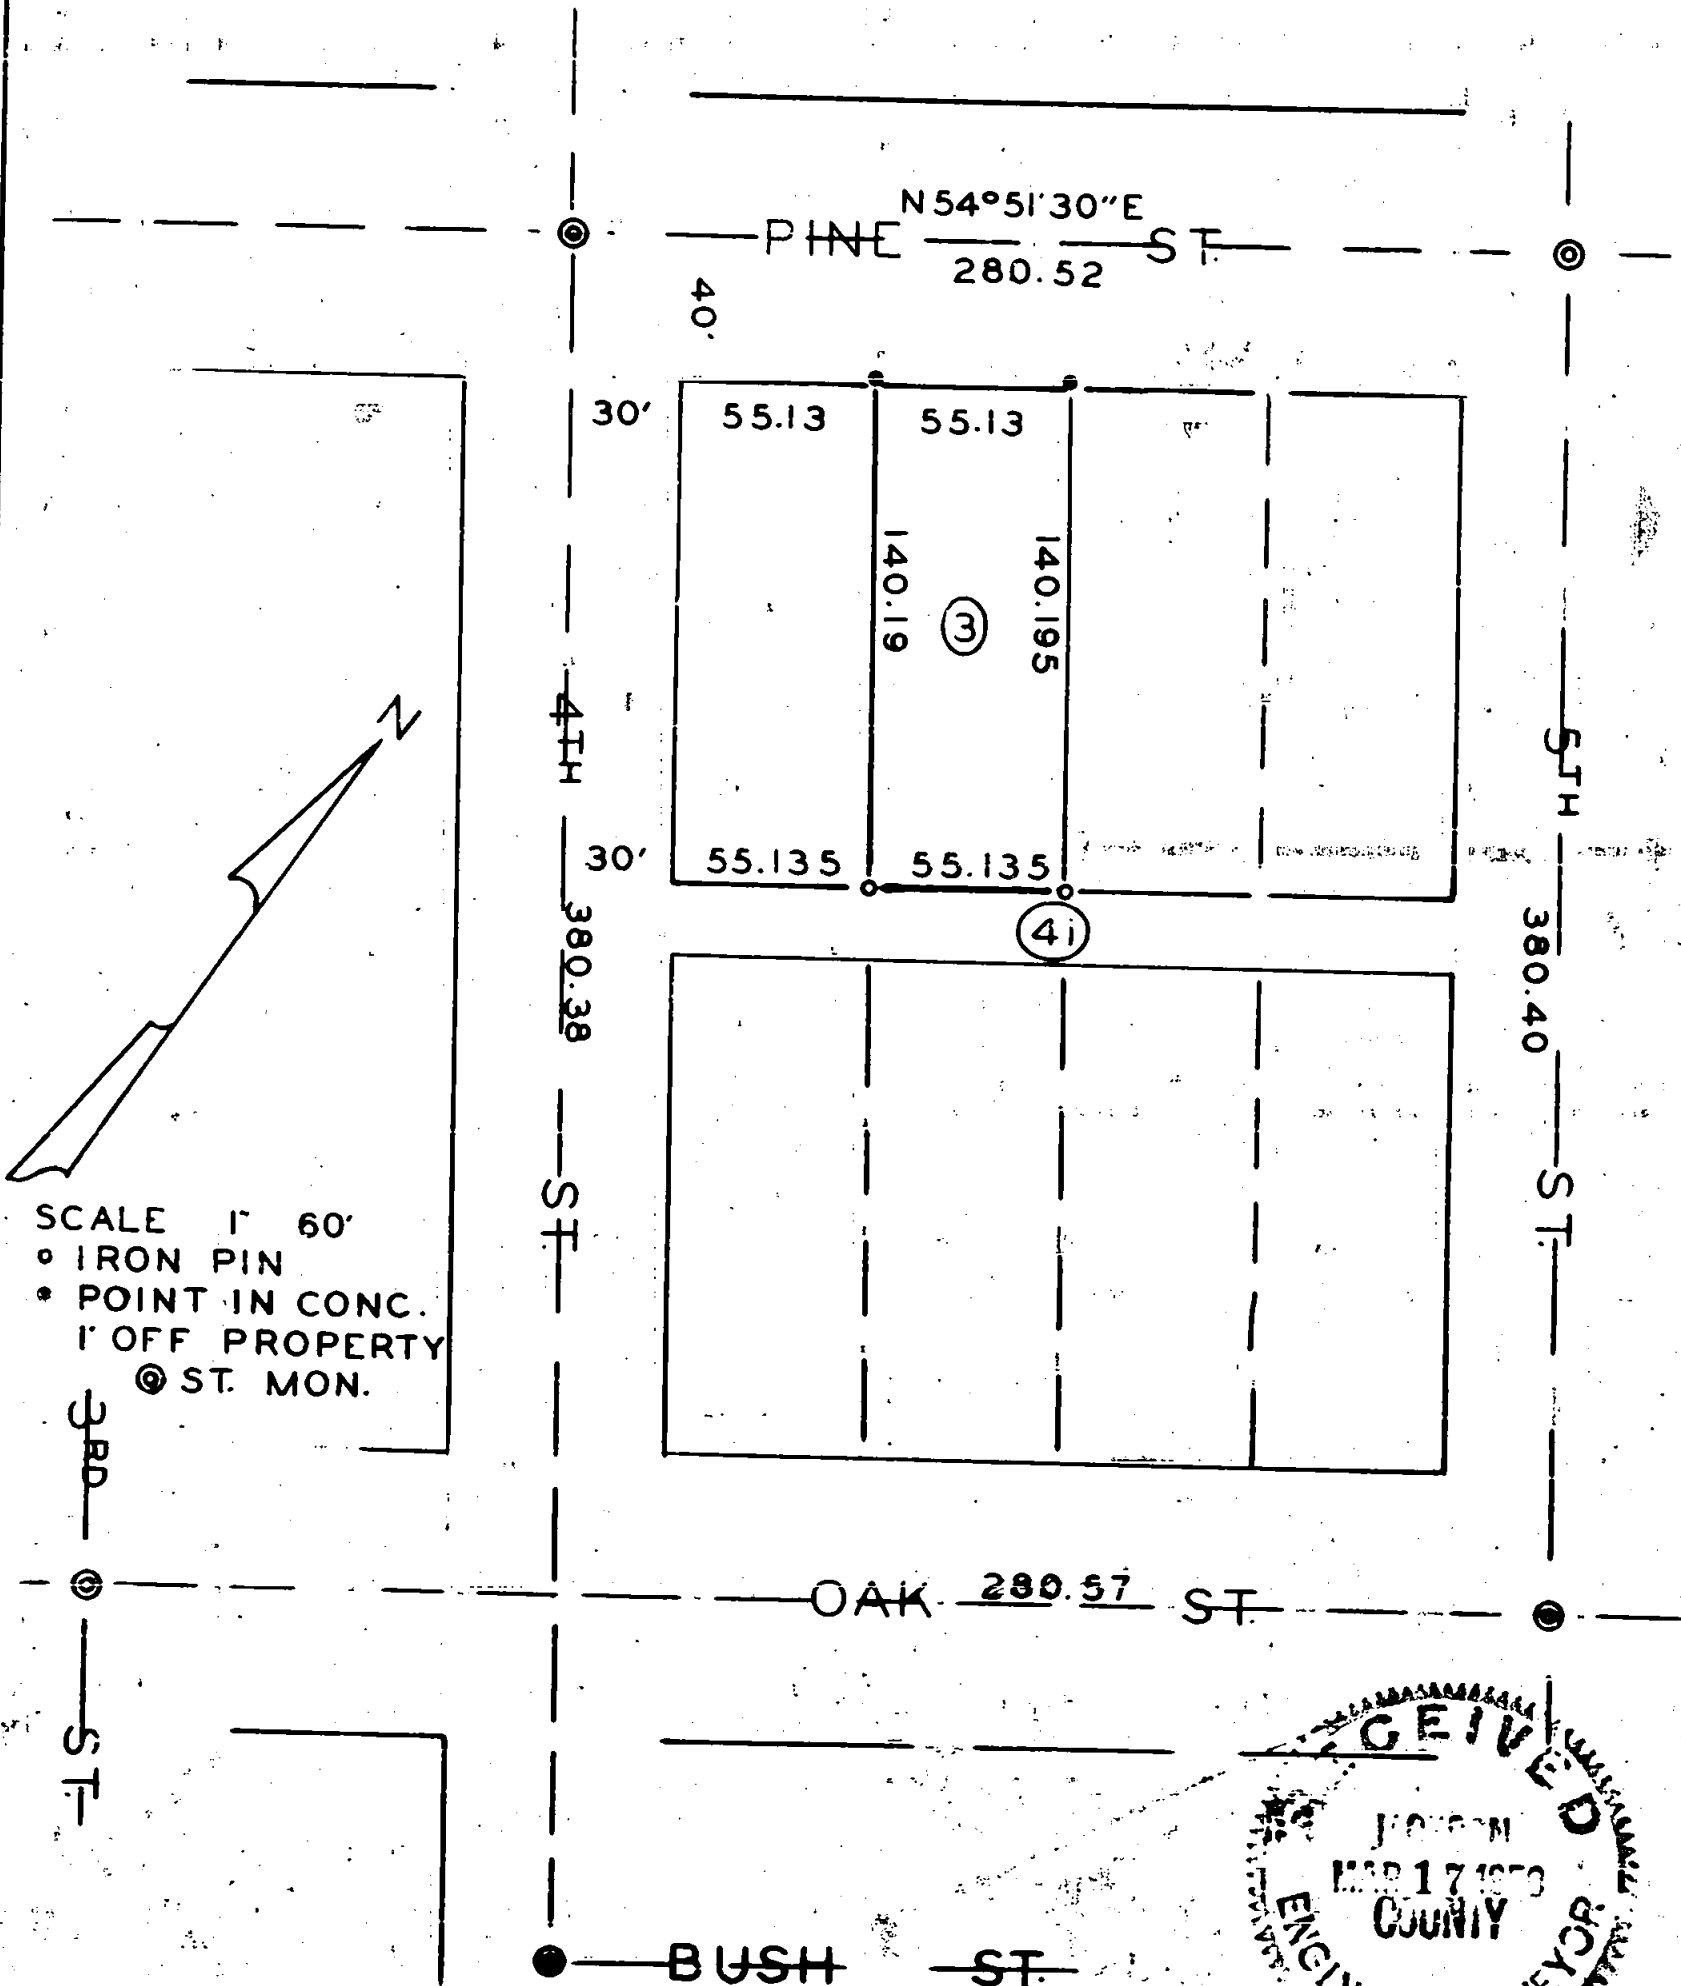

SCALE 1" = 60'
○ IRON PIN
● POINT IN CONC.
1' OFF PROPERTY
⊙ ST. MON.

RECEIVED
ENGINEER-SURVEYOR

Survey No. 223

For: L. D. LaForce

Purpose of survey: To determine and monument the boundaries of Lot No. 3, Block No. 41, of the original Town of Central Point.

Using the existing center-line street monuments at the intersections of 3rd and Oak Streets and 5th and Oak Streets, also monuments at 4th and Pine and 4th and Bush Streets, established the intersection of the street center-lines at 4th and Oak. Then by using the said street monuments at the other three corners of Block No. 41, determined the length of the boundaries of said block and then established the boundaries of Lot No. 3 on a proportional basis determined by the ratio between record and measured distances. Iron pin monuments were set for the two southerly corners and points were set in the concrete sidewalk being on the lot lines extended one foot into Pine Street.

March - 1950.

REGISTERED
OREGON
LAND SURVEYOR

C. Z. Boyden

MARCH 10, 1944
C. Z. BOYDEN
7

ENGINEER-SURVEYOR
MAY 17 1950
COUNTY