



#224

M. A. CRAMER

LOCATED IN D.L.C. NO. 78, SECTION NO. 34, T.37S., R.2 W.
APRIL 1950

REGISTERED
OREGON
LAND SURVEYOR
C. Z. Boyden
MARCH 10, 1944
C. Z. BOYDEN
7

224

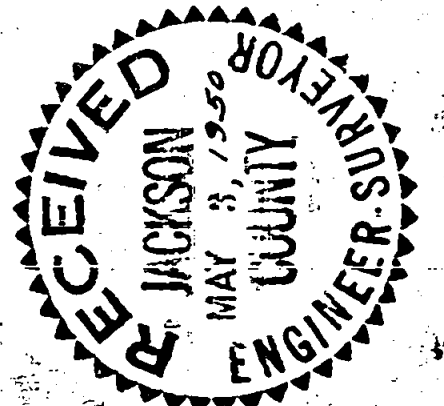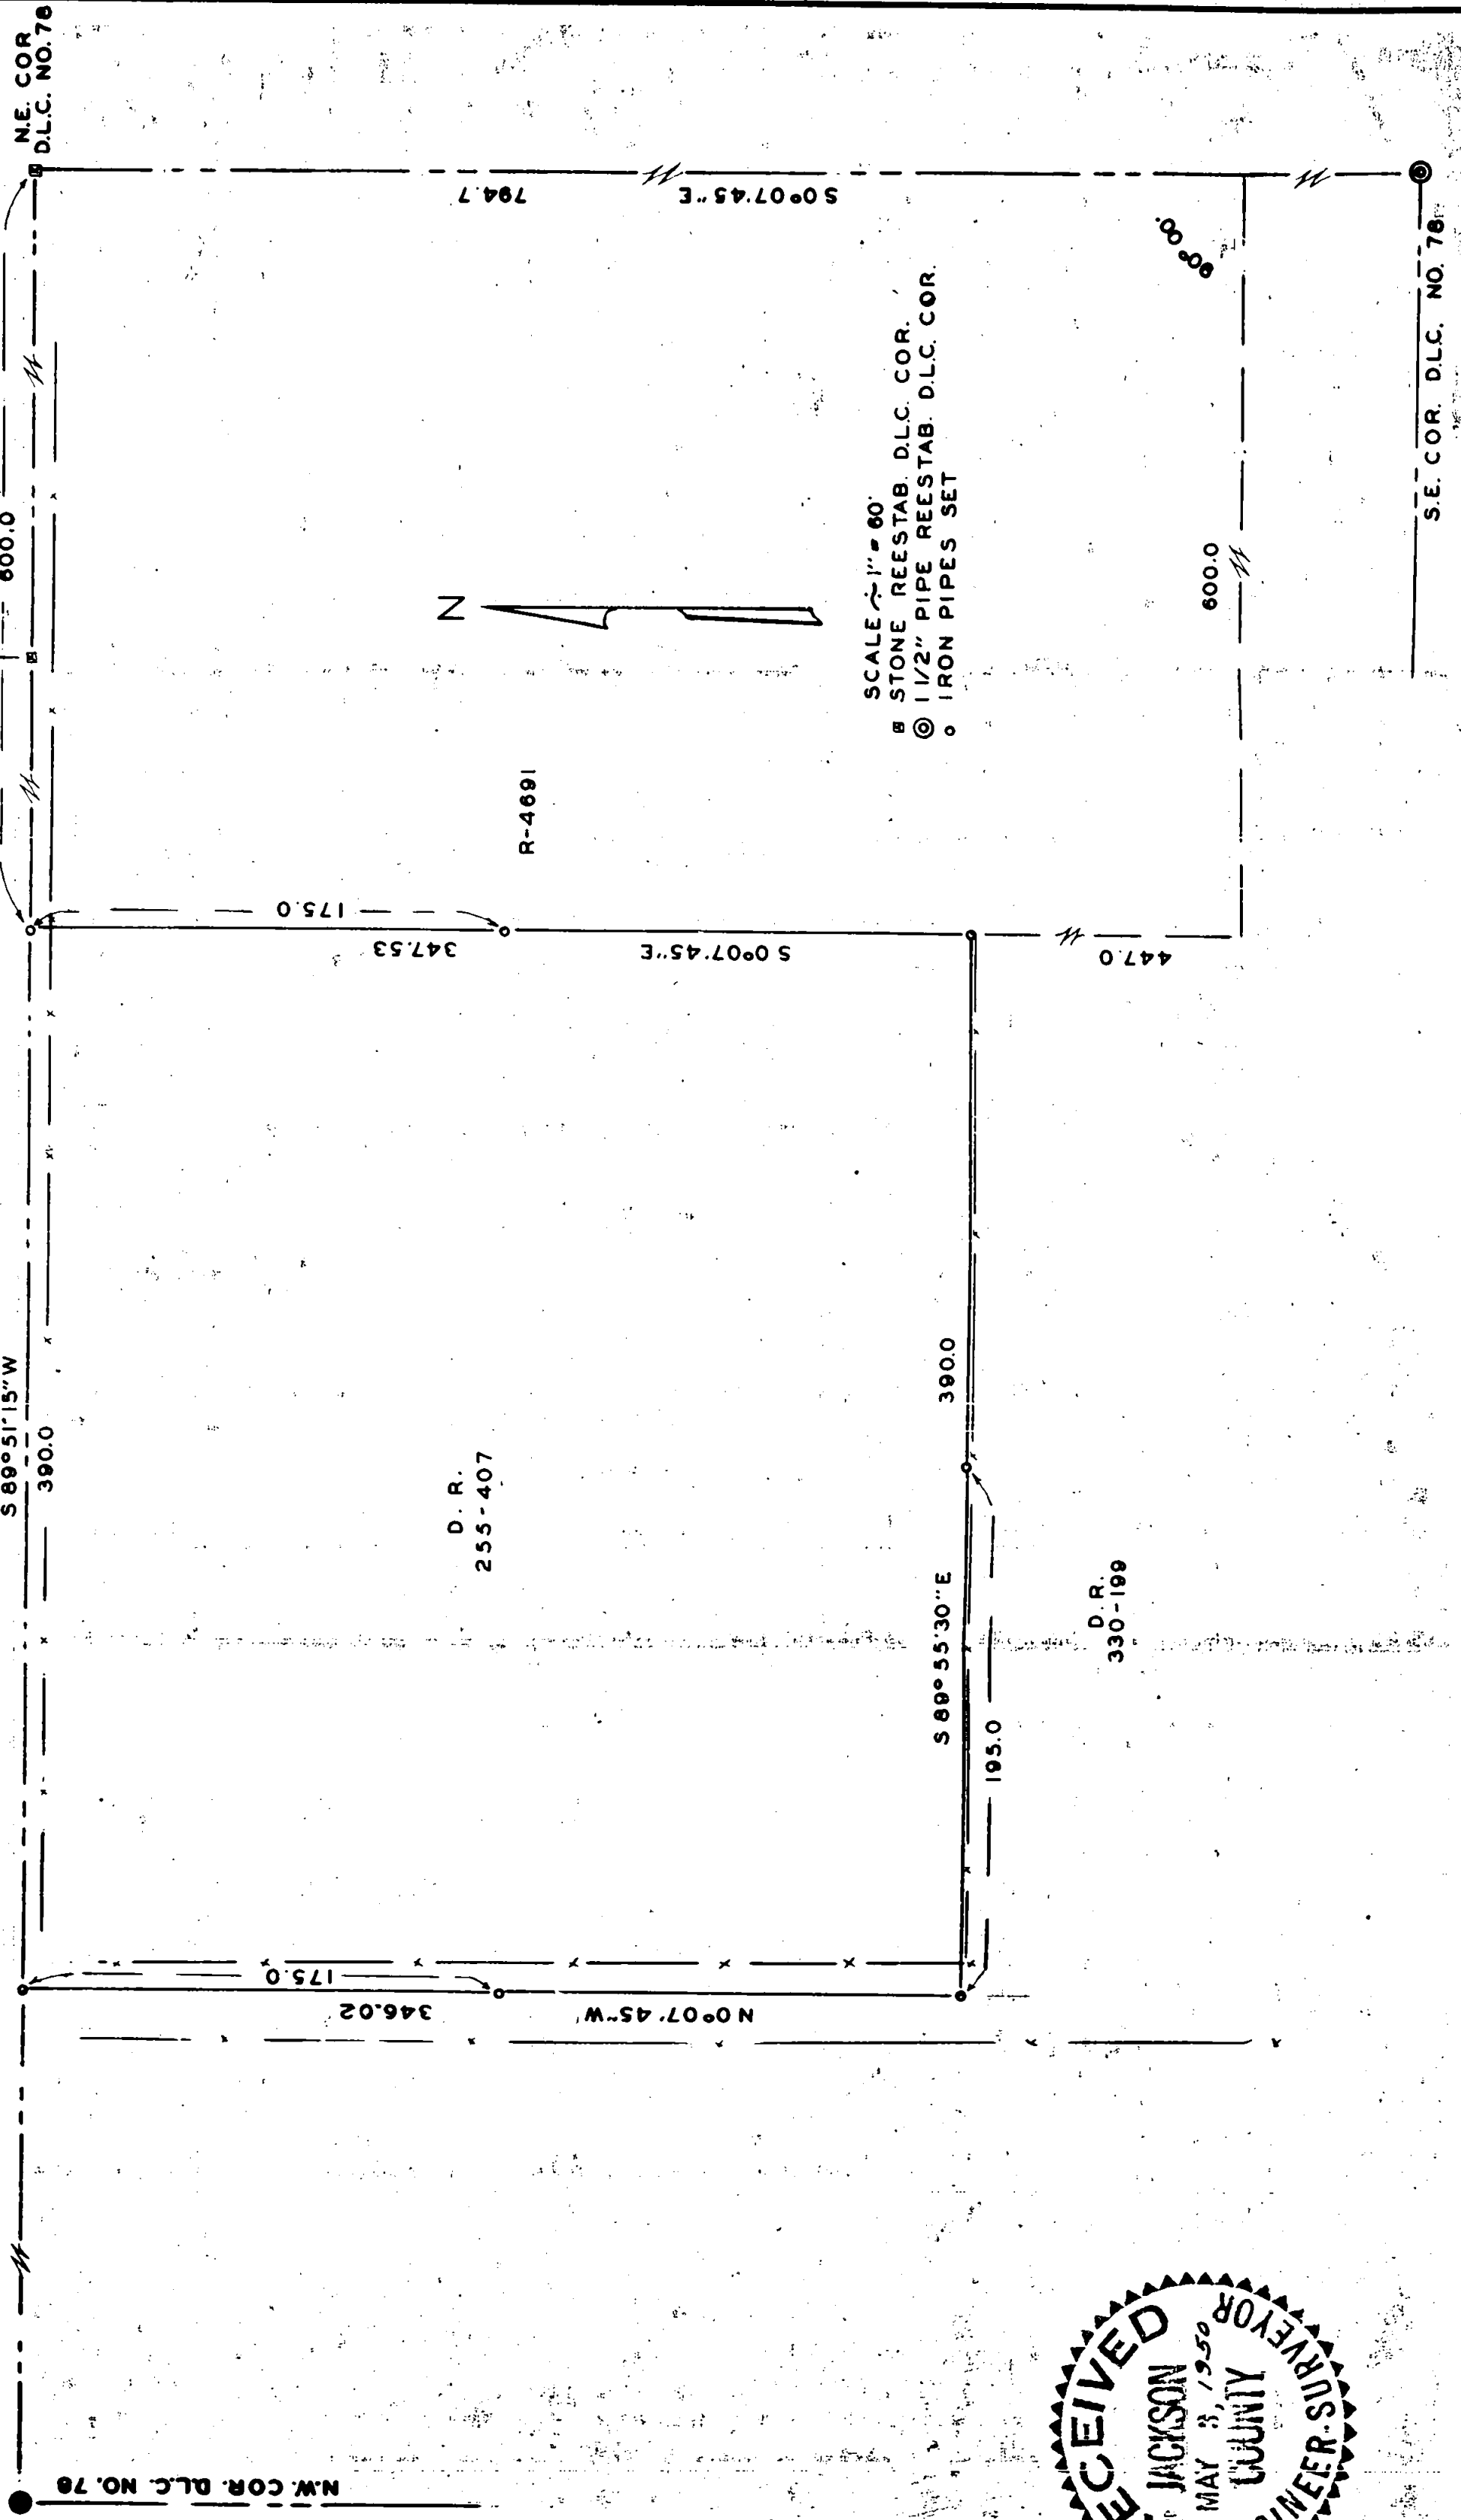

T. 375. R. 2 W.
Sec 34, T. 37.5. R. 2 W.

Survey No. 224

For: M. A. Cramer

Purpose of Survey: To establish the boundaries of the property described in Jackson County Deed Records, Volume 255, Page 407 and to set intermediate points on the boundaries as directed.

Determined the courses of the East and North boundaries of D.L.C. No. 78 and the angle of intersection at the Northeast corner of said D.L.C. The location of these boundaries was determined between the officially re-established corners at the N.E., S.E., and N.W. corners of D.L.C. No. 78 and the S.E. corner of D.L.C. No. 75 which was found to be on line between the two north corners of D.L.C. No. 78. Then determined that the point of beginning of the Cramer property would be as follows: beginning at the N.E. corner D.L.C. No. 78; thence S. 0° 07' 45" E. along the East boundary of said D.L.C., 794.7 feet; thence at right angles to the East boundary S. 39° 52' 15" W. 600.0 feet; thence N. 0° 07' 45" W. 447.0; thence N. 0° 07' 45" W. 347.53 feet to the North line of said D.L.C. No. 78 being 600.0 feet from the Northeast corner of said D.L.C. No. 78 for the Northeast corner of said property and then staked the property as shown on the map to accompany this report.

Meridian control for this survey was determined by solar observation. From the 1 1/4" x 30" iron pipe set for the Southeast property corner found a 3/4" pipe with brass disc marked RE 2391 which bears East 0.45 feet also from the 1 1/4" x 26" iron pipe set for the Southwest property corner found a 3/4" pipe with brass disc which bears 13.2 feet East and 1.6 feet South;

The existing fence line near the South boundary of the property falls South 1.0 feet of the property line at the Southeast property corner and 2.6 feet South near the Southwest property corner.

April, 1950

REGISTERED
OREGON
LAND SURVEYOR

C. Z. Boyden

MARCH 10, 1944
C. Z. BOYDEN
7

RECEIVED
JACKSON
MAY 3, 1950
COUNTY
ENGINEER-SURVEYOR