


SURVEY FOR
NEWTON A. MEAD
ORIGINAL TOWN - CENTRAL POINT, ORE.
MAR. 1950.

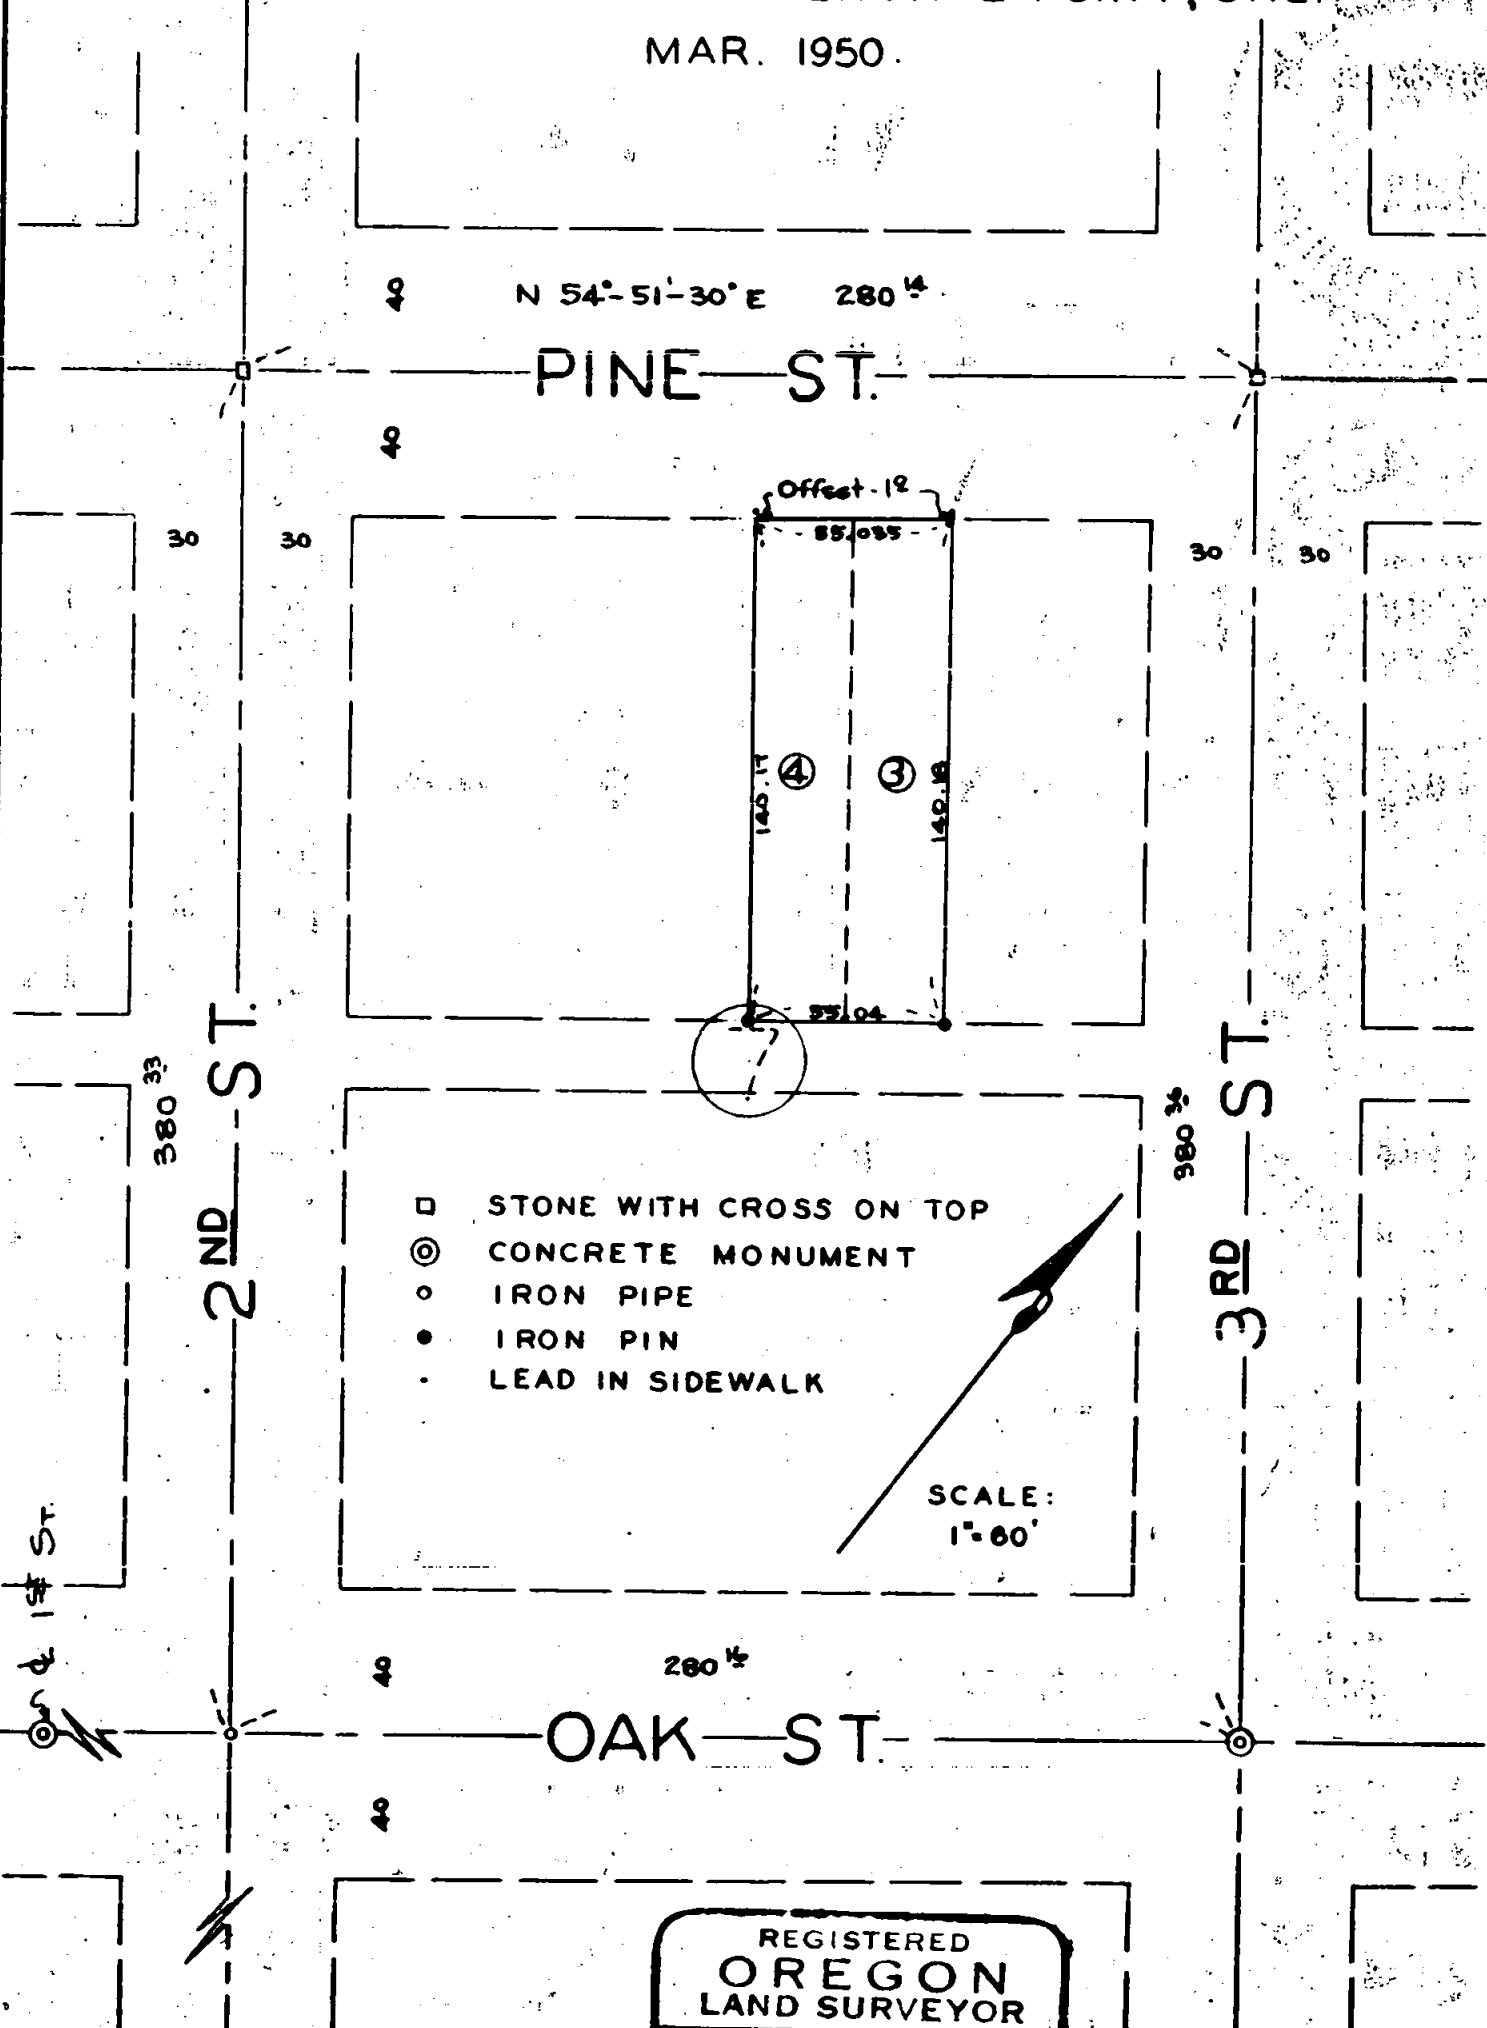

- STONE WITH CROSS ON TOP
- ⊙ CONCRETE MONUMENT
- IRON PIPE
- IRON PIN
- LEAD IN SIDEWALK

SCALE:
1" = 60'

REGISTERED
OREGON
LAND SURVEYOR

C. Z. Boyden

MARCH 10, 1944
C. Z. BOYDEN
7

RECEIVED
MAY 9, 1950
ENGINEER-SURVEYS

Survey No. 234

For: Newton A. Mead

Purpose: To locate and monument the outside boundary enclosing Lots 3 and 4, Block 7, Original Town, Central Point, Oregon.

Procedure:

Found the official centerline street monuments at Second and Pine, Third and Pine, Third and Oak Street, and the iron pipe at Second and Oaks Street (said iron pipe having been set previously by myself, using also the official centerline street monuments at First and Oak and Second and Alder Streets to make the intersection).

Measured the distances between the monuments around said block and from said information subdivided the block on a proportion between record and measured distances, and monumented said lots as shown on the attached plat.

Special note should be made regarding the two corners along Pine Street which were not actually set, but referenced by lead slugs in the sidewalk set on the lot lines extended one foot out into said street.

March - 1950.

REGISTERED
OREGON
LAND SURVEYOR

C. Z. Boyden
MARCH 10, 1954
C. Z. BOYDEN
7

