



**PROPERTY SURVEY**  
 FOR  
**HOWARD V. WALTERS**  
 SITUATE IN D.L.C. NO. 49 AND LOT 4,  
 SEC. II, T. 38 S., R. 2 W., W.M.  
 JACKSON COUNTY, OREGON  
**JAMES H. CLABBY** CIVIL ENGINEER  
 MEDFORD, OREGON NOVEMBER 28, 1949  
 SCALE - 1" = 100'

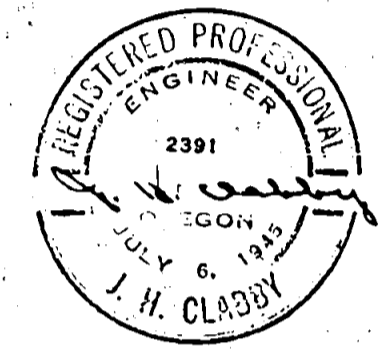

NOTE: ALL BEARINGS ON PLAT BASED ON RECORDS.  
 RECORD NORTH EQUALS N.0° 09' E. BY SOLAR OBSERVATION.

• INDICATES 1" DIAM. IRON PIPE SET.

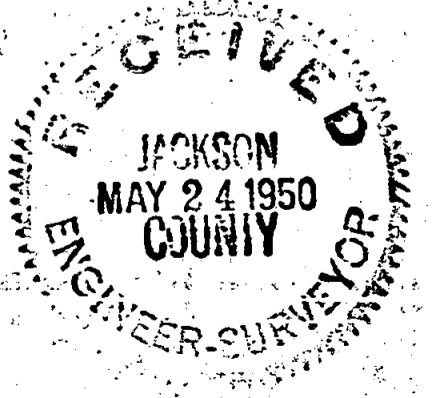

Survey No. 239

Survey Narrative to Comply with Section 87-330, 1947 Oregon State Laws.

Survey No. **239**

Survey for: Mr. Howard V. Walters  
Section 11, Township 38 South, Range 2 West, Willamette Meridian,  
Jackson County, Oregon

Purpose of Survey:

To establish boundary lines.

Survey Procedure:

Located northeast corner of D.L.C. No. 48, ran south 542.35 feet to southeast corner of D.L.C. No. 48, thence west 307.42 feet (using northwest corner of D. L. C. No. 49 as foresight) and set a 1" iron pipe; thence South 18° 00' West 327.82 feet, along county road and set an iron pipe; thence South 88° 54' East 22.85 feet and set a 1" pipe; thence South 88° 54' East 1602.54 feet and set a 1" iron pipe; thence South 65° 36' 50" East 201.55 feet and set a 1" iron pipe; thence North 426.31 feet and set a 1" iron pipe; thence ran west 320.00 feet and set a 1" iron pipe; thence west 305.28 feet and set a 1" iron pipe; thence north 542.35 feet and set a 1" iron pipe; thence west 780.66 feet to the northeast corner of D. L. C. No. 48, the point of beginning.

See plat for additional iron pipe.

J. H. Clabby

January 14, 1950

