


#240

SURVEY FOR
 CENTRAL POINT SCHOOL DIST. 6-C
 SEC. 3 T37 S R2W
 FEB. 1950.

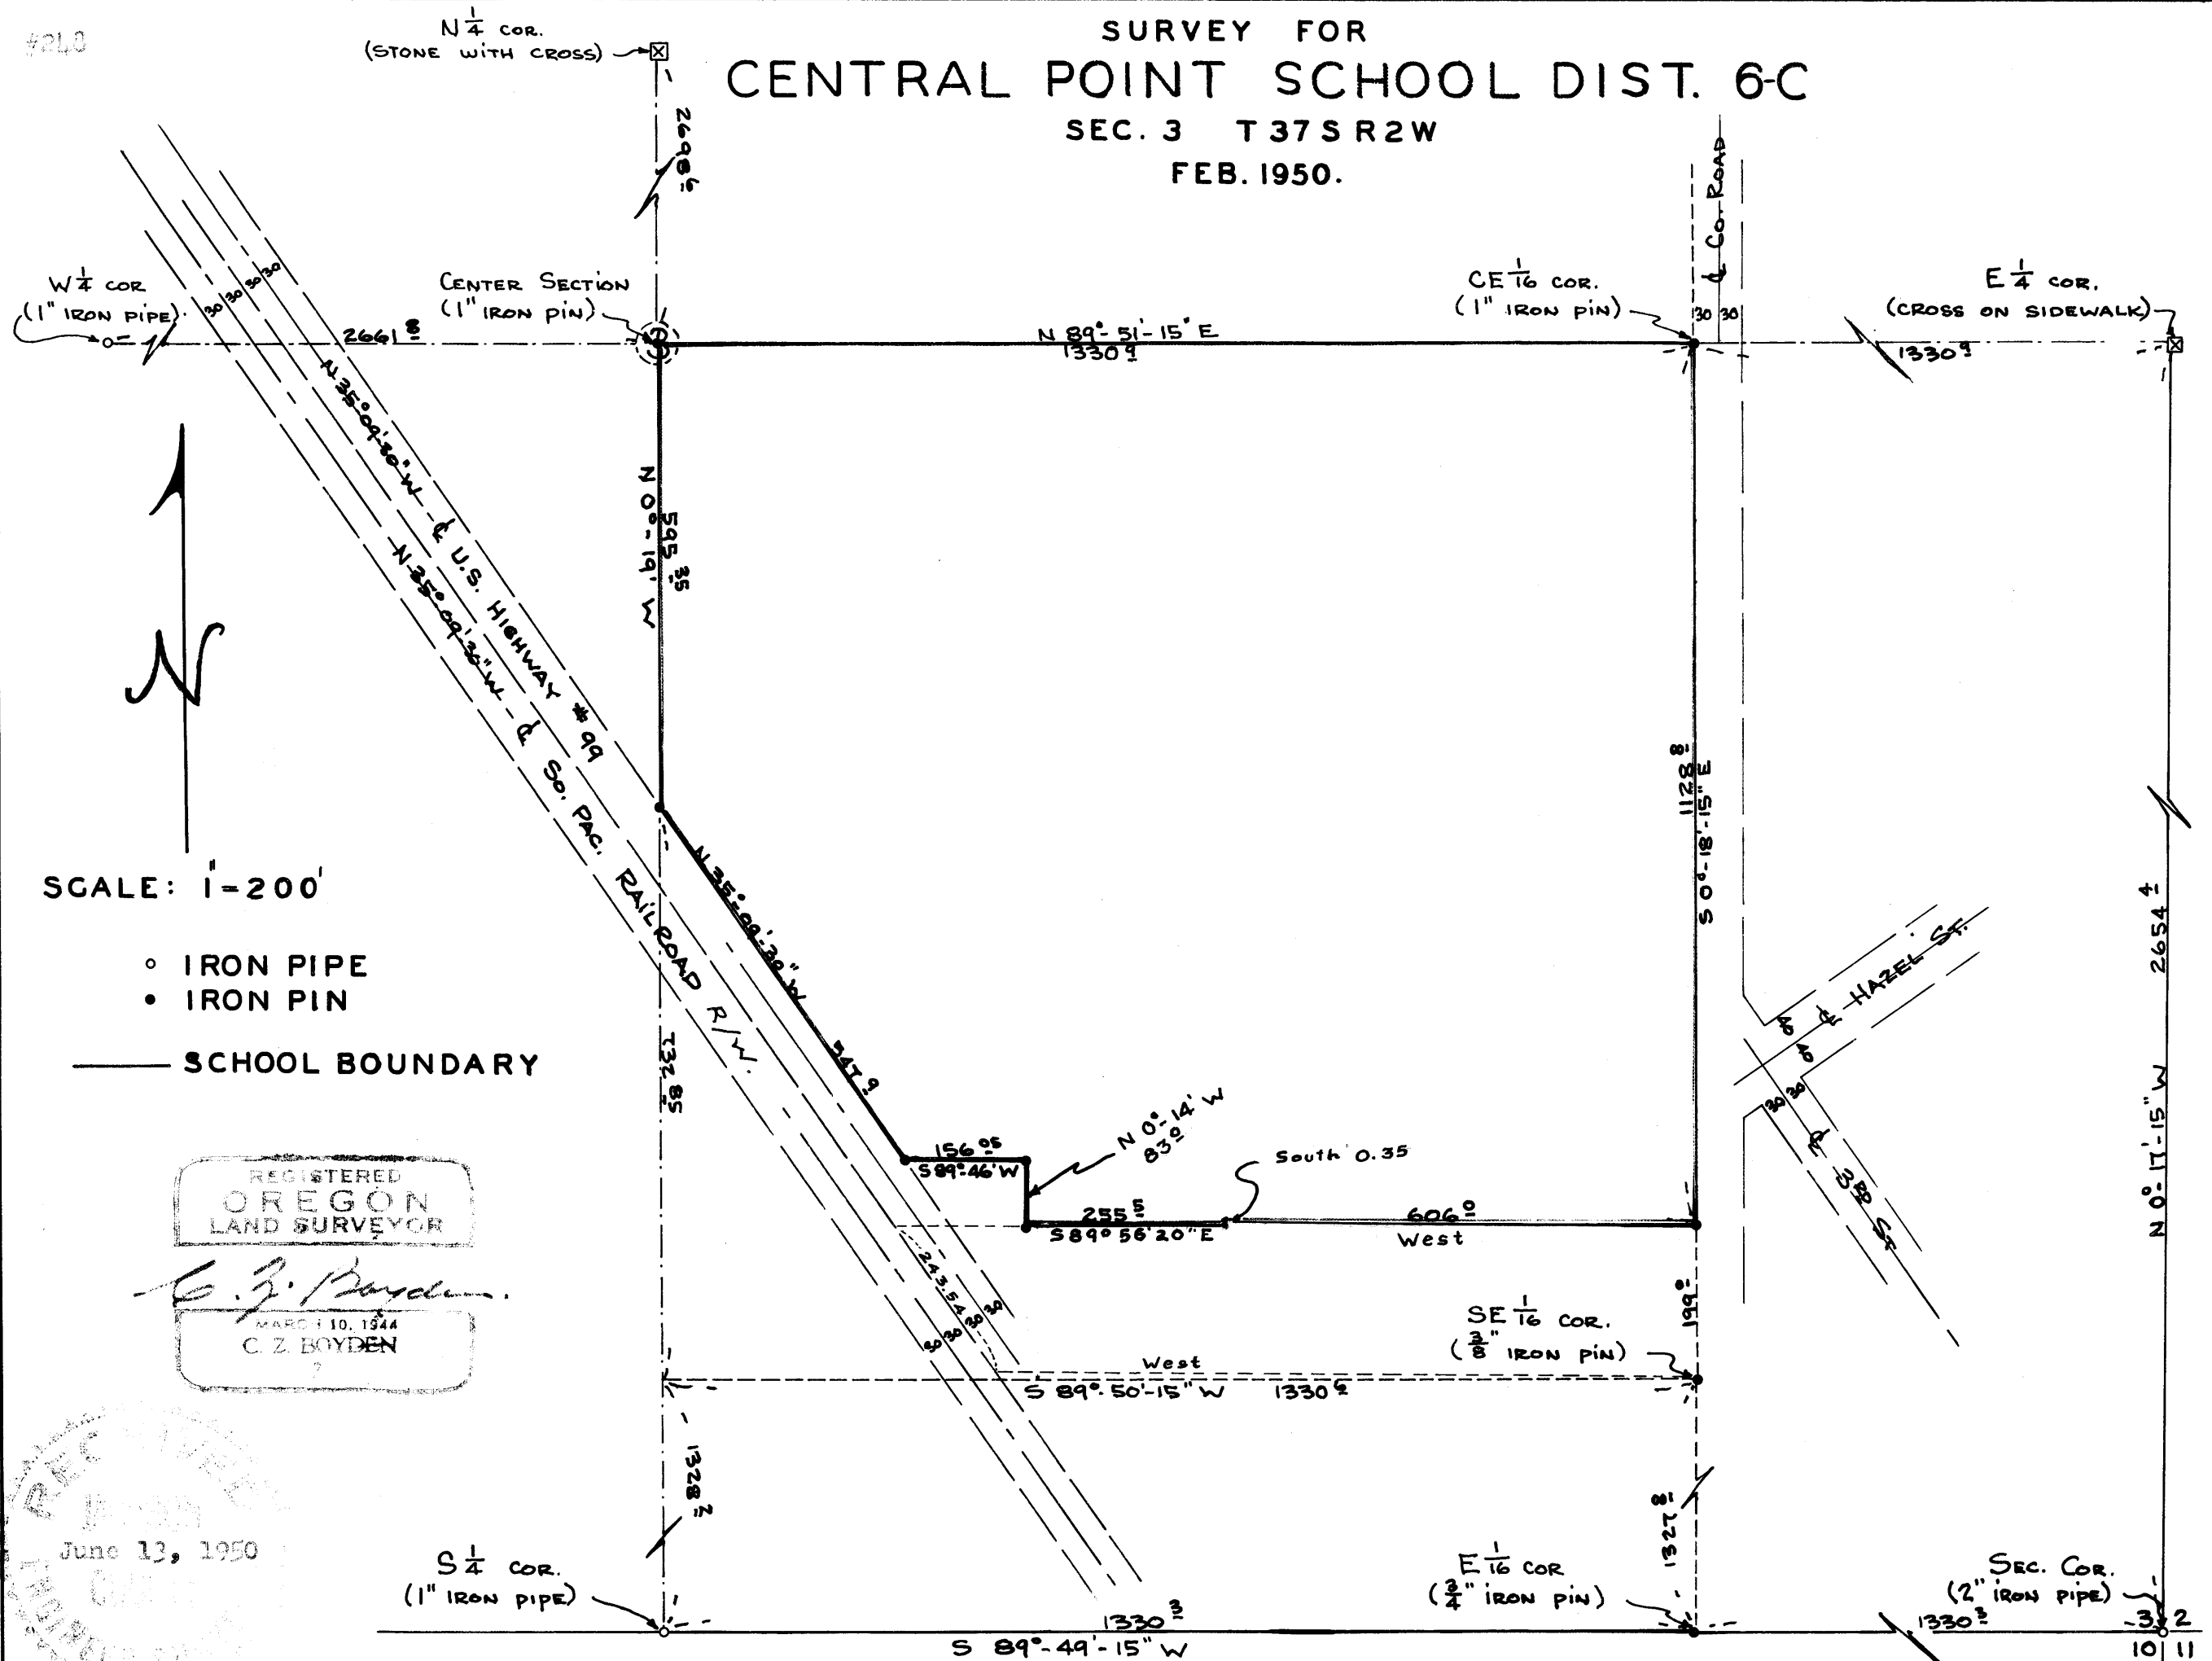

SCALE: 1"=200'

- IRON PIPE
- IRON PIN
- SCHOOL BOUNDARY

REGISTERED
 OREGON
 LAND SURVEYOR

C. Z. Boyden

MARCH 10, 1944
 C. Z. BOYDEN

REC'D
 JUNE 13, 1950

SURVEY NARRATIVE TO COMPLY WITH SECTION 87-330

1947 Oregon State Laws.

Survey No. 248

For: Central Point School District No. 6-C.

Purpose: To locate the boundary lines of that tract of land deeded to said school district from Helen Bowers Condit located in Amy's Cottage Addition to Central Point, Oregon.

Procedure: From the four quarter corners and the Southeast Section corner of Section 3, Township 37 South, Range 2 West, (See official re-established corner records), subdivided the $SE\frac{1}{4}$ of said section of which the $NW\frac{1}{4}$ of said $SE\frac{1}{4}$ is that property also described as Lots 1, 2, 3, & 4, of said Amy's Cottage Addition. Thence ran around the said school property tract as follows:

Began at a 1" iron pin, the center of said Section 3, also being the Northwest corner of Lot No. 4, said Addition, and ran N. $89^{\circ}-51'-15''$ E. 1330.9 feet to the C.E. $1/16$ Section corner and the Northeast corner of said Lot No. 4; thence South $0^{\circ}-18'-15''$ E. along the $1/16$ Section line, being the East boundary of said Addition, 1128.8 feet (from which point the SE $1/16$ Section corner of said Section 3, bears South $0^{\circ}-18'-15''$ E. 199.0 feet.)

Thence West 606.0 feet along the North line of the property described in Jackson County Deed Records, (Volume 268, page 357.) Thence South 0.35 of a foot to the North line of the property described in DR 47-616; thence N. $89^{\circ}-56'-20''$ W. along the North line of said DR 47-616, 255.5 feet; thence ran a deed record course of N. $0^{\circ}-14'$ W. (See DR 288-513) 83.00 feet to the iron bolt corner monument (the Northeast corner monument referred to in said DR 288-513); thence ran along the North boundary of said property S. $89^{\circ}-46'$ W. 156.05 feet to the intersection with the Northeasterly right-of-way line of U.S. Highway 99; (said highway right-of-way was located parallel to and 90.0 feet from the center-line of the Southern Pacific Railroad right-of-way.)