


BEARINGS DERIVED BY SOLAR OBSERVATION



### PROPERTY SURVEY

SITUATE IN SEC. 9 & SEC. 10, T. 37 S., R. 1 W., W.M.  
JACKSON COUNTY, OREGON

CLABBY & LOVEJOY MEDFORD, OREGON  
APRIL 6, 1950 SCALE 1" = 500'

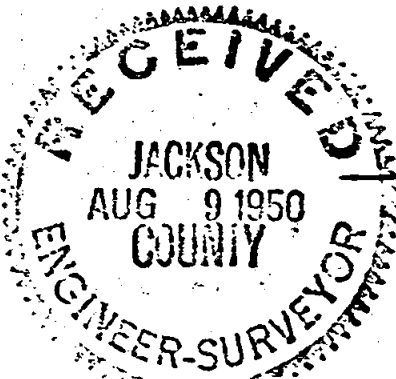

Survey No. 254

Survey Narrative to Comply with Sec. 87-330, 1947 Oregon State Laws.

Survey for: Herb Grissom  
Medford, Oregon

Purpose of survey:

To locate property lines.

Survey Location:

Sections 9 and 10, T. 37 S., R. 1 W., W.M., Jackson County, Oregon.

Survey procedure:

Located iron pipe at southwest corner of northeast quarter of northeast quarter of Section 9. Ran southerly and found two 1" galvanized iron pipe. Tied section corner common to Sections 9, 10, 15 and 16. Set property corners as shown on attached plat. Bearings by solar observation.

J. H. Clabby

April 1950.

Survey No. 254

