

BOUNDARY LOCATION
 PROPERTY SITUATE IN THE
 NW 1/4 SEC. 36, T36S, R2W, WM
 JACKSON COUNTY,
 OREGON.

1/4 SEC.
 CORNER
 36
 1

RECEIVED
 JACKSON COUNTY
 AUG 9 1950
 ENGINEER-SURVEY

CLABBY & LOVEJOY
 JUNE 21, 1950

MEDFORD, OREGON
 SCALE: 1" = 50'

REGISTERED PROFESSIONAL
 ENGINEER
 2391
 OREGON
 JULY 6, 1943
 J. H. CLABBY

Survey No. 256

Survey Narrative, to Comply with Section 87-330, 1947 Oregon State Laws.

Survey for: James R. Lees
Wilson Road
Central Point, Oregon

Location: Located in NW 1/4 Section 36, Township 36 South, Range 2 West, Willamette Meridian, Jackson County, Oregon



Survey Procedure:

Located iron pin at center of Section 36, Township 36 South, Range 2 West, Willamette Meridian, Jackson County, Oregon, and 1/4 corner common to Sections 35 and 36. Survey performed as shown on map. 5/8" iron pins set at property corners. Bearings based on solar observations.

J. H. Clabby

June 1950

Survey 256

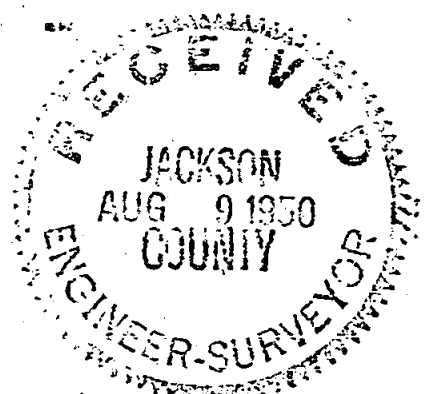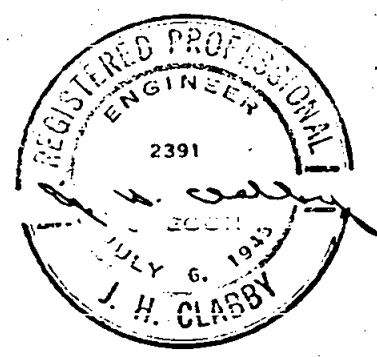

Survey Narrative, to Comply with Section 87-330, 1947 Oregon State Laws.

Survey for: James R. Lees
Wilson Road
Central Point, Oregon

Location: Located in NW 1/4 Section 36, Township 36 South, Range 2 West, Willamette Meridian, Jackson County, Oregon

Survey Procedure:

Located iron pin at center of Section 36, Township 36 South, Range 2 West, Willamette Meridian, Jackson County, Oregon, and 1/4 corner common to Sections 35 and 36. Survey performed as shown on map. 5/8" iron pins set at property corners. Bearings based on solar observations.

J. H. Clabby

June 1950

Survey 256

