

PROPERTY SURVEY

SITUATE IN THE NE 1/4 OF THE NW 1/4
OF SEC. 20, T. 38 S., R. 1 W., W.M.

JACKSON COUNTY, OREGON

CLABBY AND LOVEJOY MEDFORD, OREGON
MARCH 10, 1950 SCALE 1" = 100'

• DENOTES IRON PIN SET

50°56'42"E
72.77'
1.114 ACRES ±
413.68'
589°59'00"E

N 82°02'00"E
520.47'

133.23'
N 31°05'30"E
Q. COLEMAN

44.37'
N 45°48'30"E
CREEK



ROAD

552.59'

IRON PIPE

N 0°07'00"W
1321.64'

17
20
1/4 CORNER

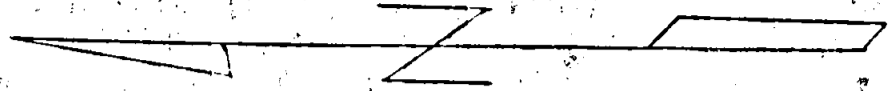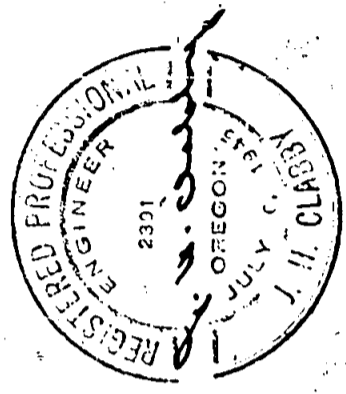

Survey Narrative to Comply with Section 87-330, 1947 Oregon State Laws.

Survey for: K. H. Kelley
Talent, Oregon

Location: The northeast quarter of the northwest quarter of Sec. 20,
Township 38 South, Range 1 West, Willamette Meridian,
Jackson County, Oregon

Survey Procedure:

Located iron pipe as shown on the map, also located an iron pipe on the south line of the tract surveyed. These two pipe were set by this office on a previous survey. The southwest corner is in a fence line which bears north, the northwest property corner is a fence corner, the northeast and southeast corners are in the center line of the existing road as shown. Iron pins set at property corners.

J. H. Clabby

March 1950

Survey No. 258

