

D. L. C. NO. 41

COR. D.L.C. No. 41 & LOT 1

STAGE

SUNSET

DRIVE

Found 1/2" Iron Pin

N. 89° 53' 30" W 298.30'
RECORD WEST 288.00'

RECORD NORTH 48.00'
N. 0° 06' 30" E. 78.00'

RECORD WEST 356' ±

N. 89° 15' 40" W 352.19'
ACCEPTED PROPERTY FENCE

SHED

IRON PIPE

2.00 ACRES ±

S. 89° 57' 30" E. 640.80'

RECORD NORTH 351'

1.67 ACRES ±

D. L. C. NO. 40

S. 89° 57' 30" E. 641.32'

1.67 ACRES ±

S. 89° 57' 30" E. 641.83'

2.00 ACRES ±

S. 89° 57' 30" E. 642.45'

2.00 ACRES ±

S. 89° 57' 30" E. 643.07'

3.00 ACRES ±

RECORD EAST
S. 89° 57' 30" E. 644.00'

GOVT. LOT 1

H I N O S RECORD SOUTH 881.00'
--S. 0° 02' 30" W 880.97'

RECORD WEST 644.00'

RECORD WEST 644.00'

W SW. Cor. D.L.C. No. 40



LEGEND

- IRON PIN, UNLESS OTHERWISE DESIGNATED
- D. L. C. CORNER FOUND

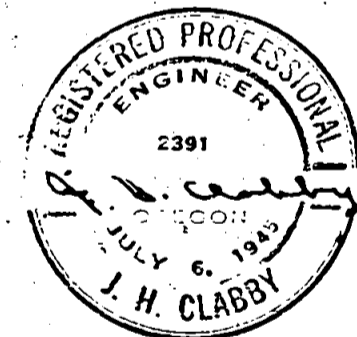


PROPERTY SURVEY

SITUATE IN D. L. C. NO. 40
IN SEC. 2, T.38 S., R.2 W., W.M.
JACKSON COUNTY, OREGON

CLABBY & LOVEJOY
FEBRUARY 23, 1950

MEDFORD, OREGON
SCALE: 1" = 100'

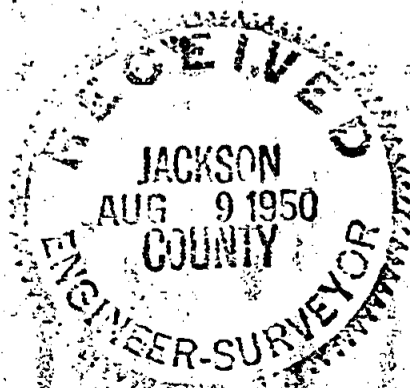

Survey Narrative to Comply with Section 87-330, 1947 Oregon State Laws.

Survey for: Dwight L. Houghton
Medford, Oregon

Location: D.L.C. 40, Sec. 2, T. 38 S., R. 2 W. W. M. Jackson County, Oregon.

Purpose of survey:

To establish property corners.

Survey procedure:

Located stone at northeast corner Govt. Lot 1 and southeast corner D.L.C. 41 for the point of beginning. Located stone at west southwest corner D.L.C.40 and used the line between the two D.L.C. corners as the west line of the property surveyed. Located iron pipe at extreme northeast corner of property at existing fence corner. Pipe has been recognized corner for many years so the fence line was accepted from the pin westerly 352.19 feet. Located 1/2" iron pin which was 30.00 feet from north northeast property corner.

Bearings based on County Road.

J. H. Clabby

February 1950

Survey No. 261

