



Survey No. 274

SURVEY FOR
FLOYD HILTON
IN CENTRAL POINT ORE
T37SR2W SEC. 3
SEPT. 1950

REGISTERED
OREGON
LAND SURVEYOR

SCALE: 1"=200'

- IRON PIPE
- IRON PIN
- ⊙ RE-ESTABLISHED CORNER

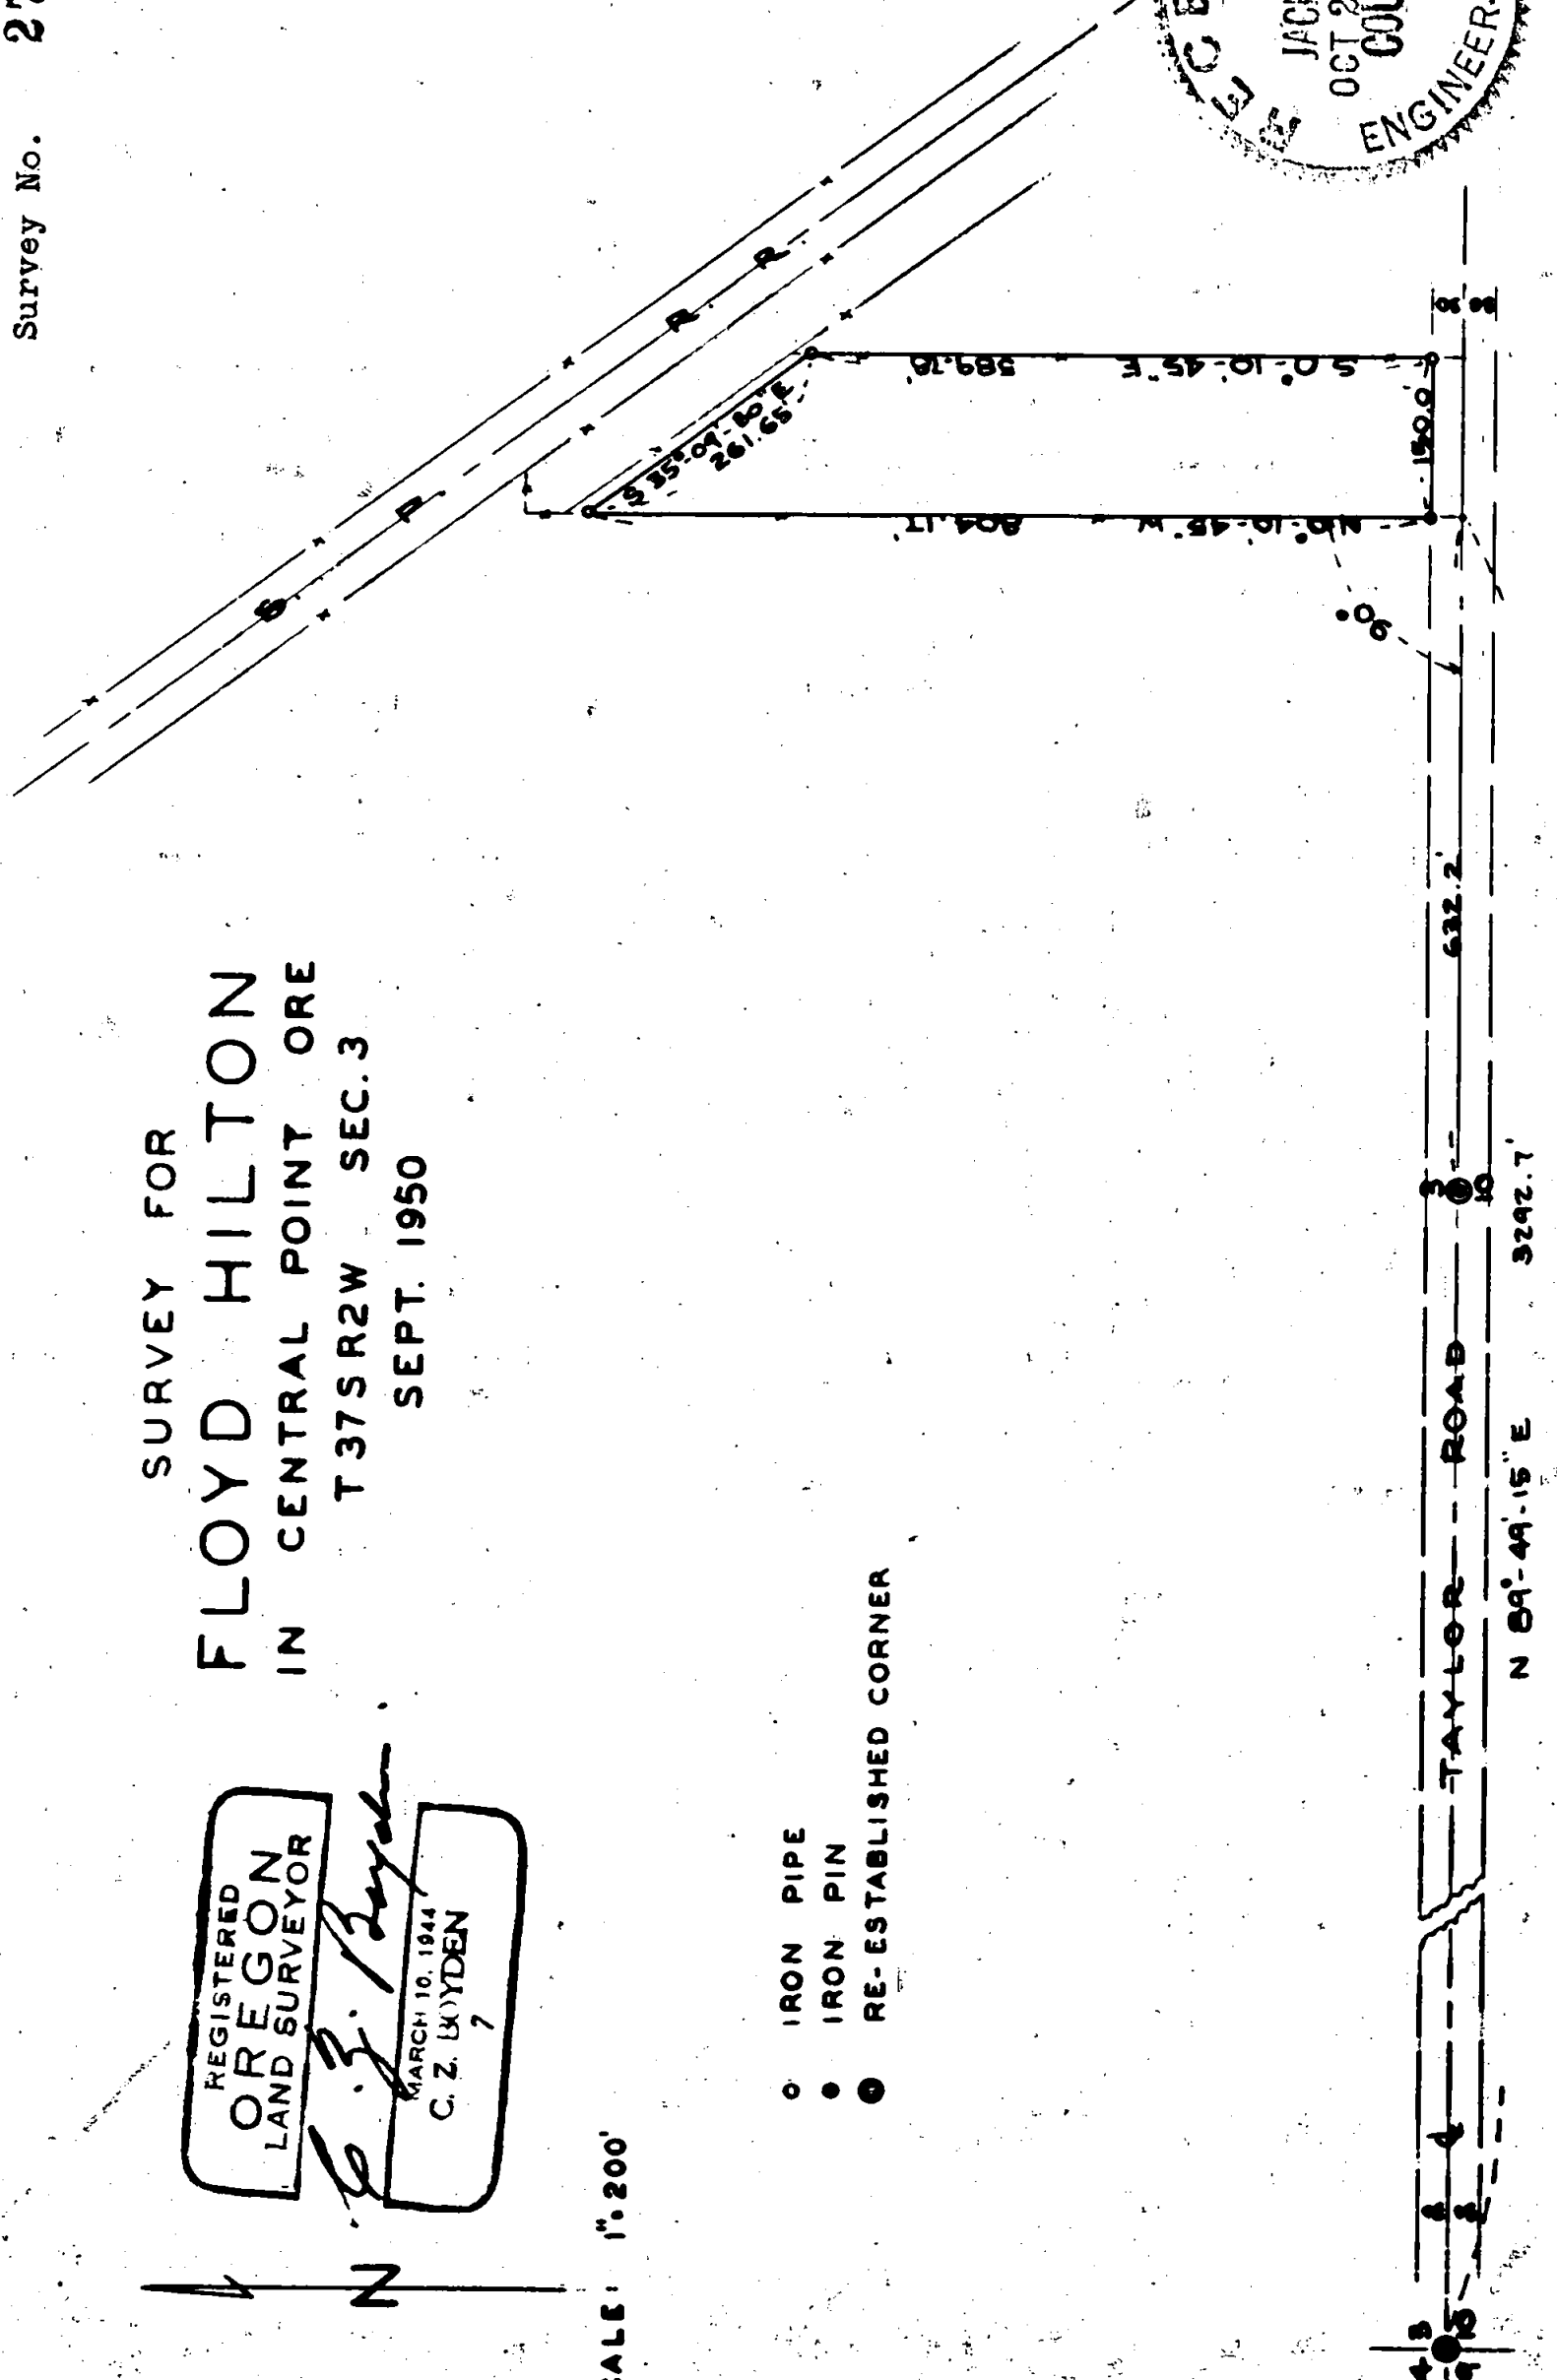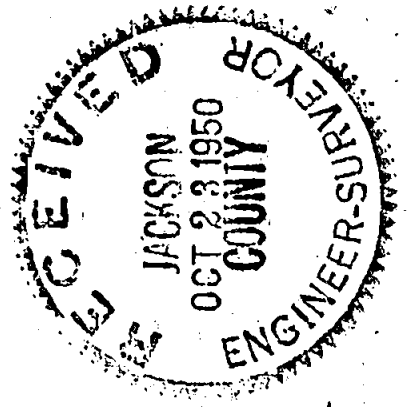

Filed in Section 3, Township 37 South, Range 2 West.

Survey Narrative to comply with Section 87-330 Oregon State Law 1947

Survey No. 274

For: Floyd R. Hilton et ux

Purpose: To establish and monument the property lines described in Jackson County Deed Record Volume 241, Page 101, located in the City of Central Point--Section 3, Township 37 South, Range 2 West.

Procedure: Using the re-established corner to sections 3, 4, 9, and 10, and the proportioned south $\frac{1}{4}$ corner of section 3 for control, ran the record distance of said deed record, 3292.7 feet along the South Boundary of Section 3 for the point of beginning:

Thence ran at right angles to the section line a record distance of 834.17 feet for the west line of said deed record (241-101);

Thence ran S 35° 09' 30" E parallel to the Southern Pacific Railroad right-of-way to a point 150.00 feet at right angle distance from the said west line;

Thence ran the east line S 0° 10' 45" E parallel to the west line to an intersection with said section line;

Thence ran the record distance of 150.00 feet S 89° 49' 15" W along the section line to the point of beginning.

Excepted the South 30.0 feet from said property as said strip falls in Taylor Road.

September, 1950

C. Z. Boyden

REGISTERED
OREGON
LAND SURVEYOR

C. Z. Boyden

MARCH 10, 1944
C. Z. BOYDEN
7

