

N 89° 45' 55" E.

151.80'

1/2" IRON PIN

3.07 ACRES ±

878.43'

883.25'

848.42'

853.24'

NORTH

SOUTH

1/2" IRON PIN

OREGON STATE HWY. 238

151.86'

N 88° 25' W.

914.98'

EAST

1734.87'

NORTH




SW COR  
D.L.C. 76

BOUNDARY LOCATION  
PROPERTY SITUATE IN  
D.L.C. NO. 76, T. 37 S., R. 2 W., W.M.  
JACKSON COUNTY, OREGON

CLABBY & LOVEJOY MEDFORD, OREGON

MAY 18, 1950

SCALE: 1" = 100'

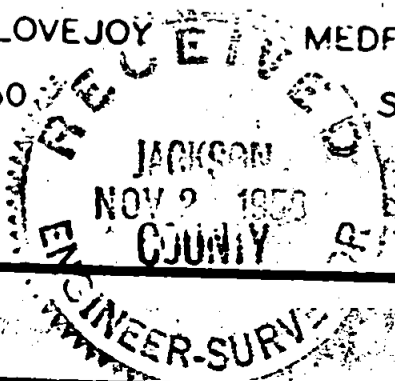

Survey Narrative to Comply with Sec. 87-330 Oregon State Laws (1947).

Survey for: T. W. Trautman  
Medford, Oregon

Location: D. L. C. No. 76, Township 37 South, Range 2 West, Willamette  
Meridian, Jackson County, Oregon

Purpose of Survey:

Boundary location.

Survey Procedure:

Could not find northwest corner D.L.C.No. 76, Township 37 South, Range 2 West, Willamette Meridian, Jackson County, Oregon. Found iron pipe 5" under road shoulder for east southeast corner D. L. C. No. 72. Ran to east northeast corner D.L.C. No. 76, said corner being an iron pipe 3" below surface of private driveway. Ran to "L" corner of D.L.C. No. 76, said distance being 994.01 feet, ran thence to southeast corner D.L.C. 72, thence ran to southwest corner of D.L.C. No. 76. Property corners fit existing fences. 5/8" iron pins set at property corners. Bearings by solar observation.

J. H. Clabby

May 1950

