



NOTE:-
 No buildings on the parcel shown above, except a small outbuilding which the owners stated would be removed.

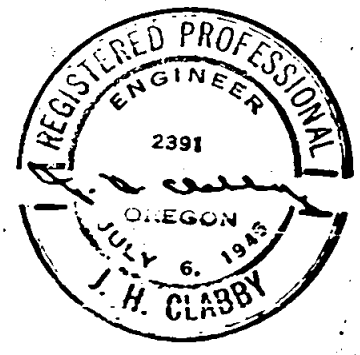

BOUNDARY LOCATION
 PROPERTY SITUATE IN
 D.L.C. 45, T.39 S., R.1 E., W. MER.
 JACKSON COUNTY, OREGON
 J. H. CLABBY
 MEDFORD, OREGON
 AUG. 10, 1950
 SCALE: - 1" = 50'

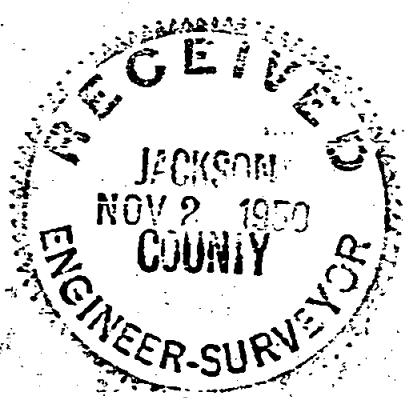

Survey Narrative to Comply with Sec. 87-330, 1947 Oregon State Laws.

Survey for: E. B. Poyer
Ashland, Oregon

Location: D.L.C. No. 45, Township 39 South, Range 1 East, Willamette
Meridian, Jackson County, Oregon

Purpose of survey:

To locate building lot.

Procedure: Located pipe monument at the intersection of Iowa and Wightman
Streets which is also the southeast corner of D.L.C.No. 39.
Located northeast corner of said D.L.C. No. 39 by offset from
reference points thus establishing center line of Wightman Street.
Ran north 353.08 feet; thence east 30.00 feet and set iron pin;
thence continuing east 100.00 feet and set iron pin; thence
continuing north on center line of Wightman Street 50.00 feet;
thence east 30.00 feet and set iron pin; thence continuing
east 100.00 feet and set an iron pin. Record bearings used.

J. H. Clabby

August 1950

