

FOUND STONE WITH  
PUNCHED METAL  
DISC ON TOP.

# PLAT SHOWING A SURVEY IN

## THE ROSE PARK ADDITION TO THE CITY OF MEDFORD. FOR MR. E. J. HEPP.

SCALE 1" = 60.00'

DEC. 13, 1949

J. A. HOFFBUHR,  
REGISTERED LAND SURVEYOR.

FOUND 3" BRASS CAP  
MONUMENT WITH "K"  
ON TOP

NOTE:

- 1" PLUGGED PIPE
- 1/2" PIPE.

ALL OVERAGES PROPORTIONED  
AND LOTS STAKED ACCORDINGLY.

PLUM STREET

WITHINGTON STREET

HAMILTON STREET

PLUM STREET

HAMILTON STREET

DAKOTA AVENUE

PLUM STREET

HAMILTON STREET

HAMILTON STREET

PLUM STREET






89° 58' 55"

90° 02'

90° 02'

90° 00' 30"

90° 00' 30"

90° 00' 30"

146.70' RECORD

146.70' RECORD

146.70' RECORD

146.70' RECORD

146.70' RECORD

146.70' RECORD

146.70' RECORD

591.00' RECORD

































50.01'

50.01'

50.02'

50.02'

50.02'

50.02'

50.02'

50.02'

50.02'

50.02'

50.02'

50.02'

50.02'

50.02'

50.02'

50.02'

50.02'

50.02'

50.02'

50.02'

50.02'

50.02'

50.01'

50.01'

Survey Narrative to Comply with Section  
87-330. 1947 Oregon State Laws.

289

Survey for; Mr. E. J. Hepp,  
Harold Brown Agency,

Location of Survey;  
Rose Park Addition to the City of Medford Oregon.

Purpose of Survey;  
To stake Lots 2-3-4-5-6-7-16-17-18-19-20-21, all  
in Block 3, said Addition.

Survey Procedure;

Located Quarter Section Corner to Section 25-36, Township  
37 South, Range 2 West of the Willamette Meridian, Jackson Co.  
Oregon. Said Corner being a 3" brass disc set in Concrete and  
Marked. Located a 1 1/2" x "x" iron pin for the center-line  
of Dakota and Plum Streets. Center-line of Dakota Determined  
by these Two points. Located a stone with a punched brass disc  
for center-line of Plum and Prune Streets. Center-line of  
Plum Street determined by said brass disc and the aforementioned  
1 1/2" pin. Located a 3" brass cap monument at the Northeast  
Corner of the Rose Park Addition. Center-line of Hamilton  
Street determined between said 3" brass disc and the above  
mentioned quarter Section Corner.

We find by actual measurement these distances and by com-  
parison-----the record.


Center-line of Dakota, from the Quarter corner to center-line  
of Plum Street, is 624.60 Actual over a Record of 624.50.

Center-line of Plum, from center-line of Dakota to center-line  
of Prune Street, is 747.04 Actual over a Record of 746.70.

Center-line of Hamilton, from quarter corner to Northeast corner  
Rose Park Add. is 591.57 Actual over a Record of 591.00.


Staked Lots accordingly, proportioning overages determined  
evenly thru-out the entire subdivision.

1" x 18" pipes set on all Street boundaries and 1/2" x 18"  
pipe set on all alley boundaries.

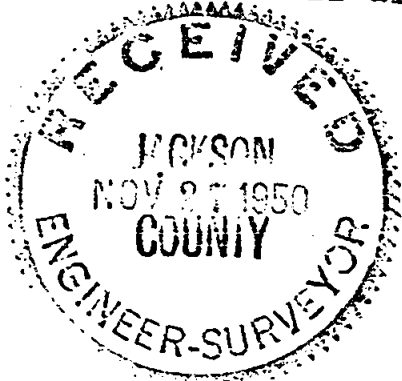

Dec. 13. 1949

J. A. Hoffbuhr,  
Registered Land Surveyor.

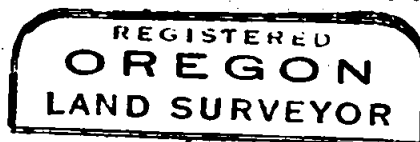

*J. A. Hoffbuhr*

