

294

NE. Cor. D.L.C. 50 T 37 S, R 1 W, W.M.

Center old Barneburg Road 1216' From Road Record No. 3 P 480

Cor. Set Nov. 4, 1950

OLD BARNEBURG RD

30' 30"

10' x 12" Yew fc. Post Set Spike on top for Bdy. Survey Nov. 4, 1950

CRESTBROOK ROAD

S 83° 30' 46" W - 226.00

N 83° 30' 46" E - 226.00

B 334 P 495

N 79° 29' 10" E - 104.81'

1.0 AC. R 1402.5 L 124.56

104.81'

N 76° 56' 30" E

927.25 Chd. Bdy. Survey Nov. 4, 1950

N 76° 56' 30" E 927.00

927.00

Round Box found

1" Iron Pin found.

BARNETT ROAD

Chd. Bdy. Survey Nov. 4, 1950

Set 5/8" x 30" Iron Rod Bdy Survey Nov. 4, 1950


133.65'

1 1/2" Iron Rod found

1" Iron Rod found

1" Iron Rod found

REGISTERED
 L. N. ROW
 LAND SURVEYOR
 MAY 6, 1947
 L. N. ROW
 294

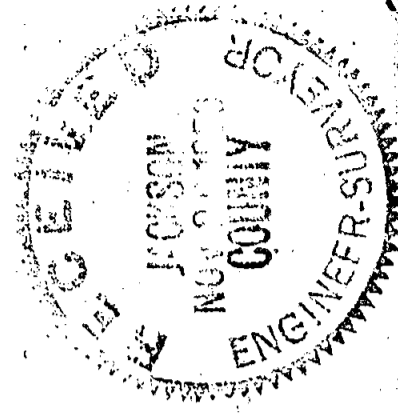

BOUNDARY SURVEY MADE NOV. 4-5, 1950

- ARE MONUMENTS SET OR FOUND NOV. 4-5, 1950
- ARE 5/8" x 30" REBAR MONUMENTS SET THIS DATE NOV. 25, 1950.

Scale 1" = 100'

294

Written narrative to accompany plat for Survey No. _____
as specified by Oregon Law.

Survey for Mr. Hugh B. Calhoun, Medford, Oregon.

Made Nov. 25, 1950.

Purpose of survey, to stake a parcel of property previously sold and recorded in Book 334 P 495 and compile a correction description using distances as given in the above mentioned deed, but correcting the bearings to conform with the boundary survey of the Calhoun property as made by L.N.Dow. on Nov. 4 & 5 1950.

Procedure, beginning at a point $S0^{\circ}01'E$ 581.5 feet and 30.00 feet east from the northeast corner of Donation Land Claim No. 50, in Township 37 South, Range 1 West, W.W. Jackson County, Oregon, I ran $S 0^{\circ}01'E$ 126.00 feet and set a $5/8"$ x $30"$ Rebar monument for the southwest corner of this parcel, then running $N 83^{\circ}30'46"E$ 226.00 feet and set a $5/8"$ x $30"$ Rebar monument for the southeast corner of this parcel, then I ran $N0^{\circ}01'W$ parallel to Crestbrook road a distance of 126.00 feet and set a $5/8"$ x $30"$ Rebar monument for the northwest corner of this parcel, thence $S83^{\circ}30'46"W$ along the boundary as surveyed Nov. 4 1950 a distance of 226.00 feet to the point of beginning.

At the request of Mr. Calhoun I then occupied the southeast corner of the above parcel and ran $S 0^{\circ}01'E$ 183.00 feet to a string intersection with the northerly boundary of Barnett road and set a $5/8"$ x $30"$ Rebar monument at this point, then I ran $S 76^{\circ} 56' 30"W$ 104.81 feet to a 1" Square iron pin monument that is the county reference pin for the P.T. of curve on Barnett road just east of Crestbrook Road. Then using the information from the boundary survey made Nov. 4, 1950 I co-ordinated this parcel and found the closure to be very good.

