


BOUNDARY LOCATION
 PROPERTY SITUATE IN
 D.L.C. NO. 59., T.37S., R.2W., W.M.
 JACKSON COUNTY, OREGON

J.H. CLABBY CIVIL ENGINEER
 MEDFORD, OREGON OCTOBER 10, 1950

SCALE - 1" = 40'

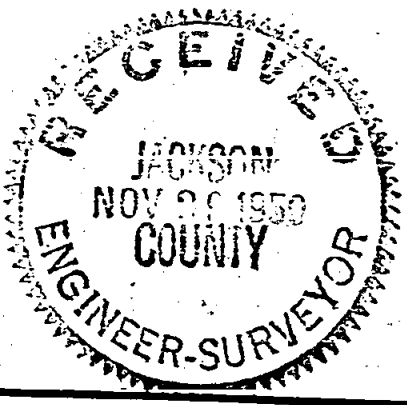

Survey Narrative to Comply with Sec. 87-330, 1947 Oregon State Laws.

Survey for: I. L. Lance

D. L. C. No. 59, Township 37 South, Range 2 West, Willamette Meridian, Jackson County, Oregon

Purpose of Survey:

To establish property line.

Survey Procedure:

Found the southwest corner of D. L. C. No. 59 and the northwest corner of D. L. C. No. 60. Used the bearing between the said corners (which bearing checked a pipe set on a previous survey) and beginning at the said southwest corner of D. L. C. No. 59, ran thence North 0° 02' West 40.26 feet and set a pipe for the southwest property corner, said corner being a true point of beginning; ran thence North 0° 02' West 200.00 feet and set a pipe; thence South 89° 52' East 100.00 feet and set a pipe; thence South 0° 02' East 60.00 feet and set a pipe; thence South 89° 52' East 5.00 feet and set a pipe; thence South 0° 02' East 140.00 feet and set a pipe; thence North 89° 52' West 105.00 feet to the point of beginning.

J. H. Clabby

October 1950

