
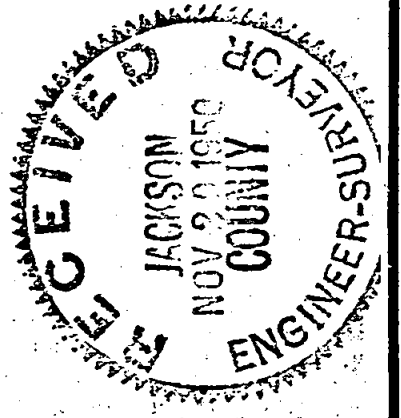


BOUNDARY LOCATION
 PROPERTY SITUATE IN SW 1/4
 NW 1/4 SEC. 25, T.37S., R.2W., W.M.
 JACKSON COUNTY, OREGON

J. H. CLABBY CIVIL ENGINEER
 MEDFORD, OREGON OCTOBER 16, 1950

SCALE - 1" = 200'

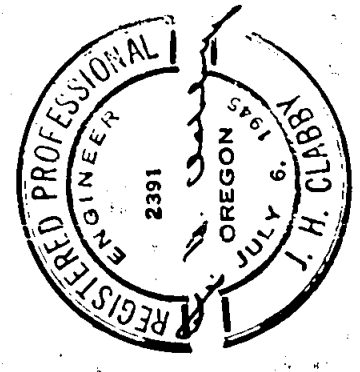

WEST 659.33'
 I.P. ACCEPTED
 SE. COR. SW 1/4
 NW 1/4 SEC 25

Survey Narrative to Comply with Sec. 87-330, 1947 Oregon State Laws.

Survey for: J. H. Clabby
SW Quarter, NW Quarter, Section 25, Twp. 37 South, Range 2 W.,
Willamette Meridian, Jackson County, Oregon

Purpose of Survey:

Boundary Survey.

Survey Procedure:

Found iron pin at southeast corner Western Addition to the City of Medford, Jackson County, Oregon and a pin 30.13 feet westerly from which an iron pipe accepted as southeast corner of southwest quarter of northwest quarter, Section 25, Township 37 South, Range 2 West Willamette Meridian. Found iron pipe at northeast corner of Regar Subdivision, unrecorded, and extended center line of Locust Street to that point as south line of survey. Retraced west line of Western Subdivision for east property line. Set north and west property lines according to descriptions of adjacent properties.

J. H. Clabby

October 1950.

