


BEARINGS DERIVED FROM C.Z. BOYDEN SURVEY  
 ° = 5/8" IRON PIN SET  
 PINS ON SOUTH END SET ON 20' OFFSET (NORTH EDGE OF COUNTY ROAD)

**BOUNDARY LOCATION**  
**PROPERTY LOCATED IN LOTS 1, 2 AND 3, OF**  
**SUNNYCREST ORCHARDS, SEC. 4, T. 37 S., R. 1 W. W.M.**

**JACKSON COUNTY, OREGON**

LELAND P. LOVEJOY REGISTERED LAND SURVEYOR  
 OCTOBER 29, 1950 SCALE 1" = 200'

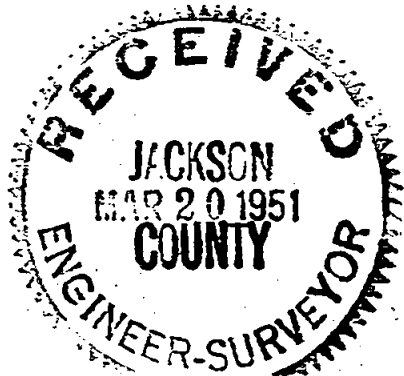

RADDER LONG

Survey Narrative to Comply with Section 87-330,

1947 Oregon State Laws.

Survey for: Willard S. Long

Medford, Oregon.

Purpose of Survey: To locate property lines.

Survey Location: Lots 1, 2, and 3, <sup>Sunnycrest</sup> ~~Crestbrook~~ Orchards, Township 37 South, Range 2 West, Willamette Meridian, Jackson County, Oregon.

Survey Procedure: Located One-Quarter (1/4) Section Corner common to Sections 4 and 9, said Township and Range, and the Southerly Sixteenth Corner of the Southeast Quarter (1/4) of Section 4, said Township and Range. Located stump of the original corner post at the Northwest Corner of Lot 3. Searched for other subdivision corners, but they have apparently been destroyed. Bearings taken from C. Z. Boyden survey. Set 5/8" iron pins at property corners.

Leland P. Lovejoy, Registered Land Surveyor

Work completed March 3, 1951.

