


331

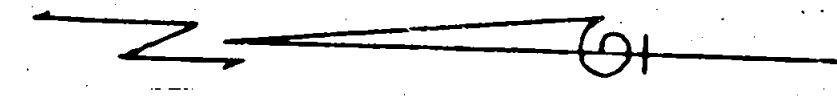

3074
 ALINDO
 MEDFORD


PROPERTY SURVEY
 FOR

PERCY J. LANDRY

SITUATE IN LOT 4, SEC. 16,

T. 38 S., R. 1 W., W.M.

JACKSON COUNTY, OREGON

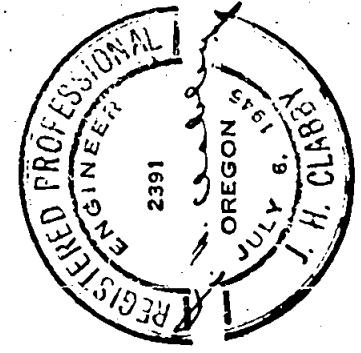

CLABBY AND LOVEJOY MEDFORD, OREGON
 JANUARY 17, 1950. SCALE: 1" = 100'

Survey Narrative to Comply with Section 87-330, 1947 Oregon State Laws.

Survey for: Percy J. Landry
Lot 4, Section 16, Township 38 South, Range 1 West, Willamette Meridian, Jackson County, Oregon

Purpose of survey:

Lot survey.

Survey procedure:

Located quarter corner common to Sections 17 and 16, Township 38 South, Range 1 West, Willamette Meridian. Also found a 2" iron pin in center of Ft. Baker Road. Offset 20 feet to the south and located the boundaries for a rectangular parcel of land 440.00 feet by 448.00 feet.

J. H. Clabby

January 1950

