


BOUNDARY LOCATION  
 PROPERTY SITUATE IN NW $\frac{1}{4}$   
 NE $\frac{1}{4}$  SEC 8 T37S R2W WM  
 JACKSON COUNTY OREGON

J H CLABBY CIVIL ENGINEER  
 MEDFORD OREGON 23 DECEMBER 1950  
 SCALE 1" = 200'

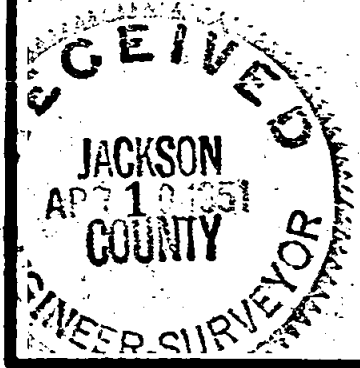

Survey Narrative to Comply with Section 87-330, 1947 Oregon State Laws.

Survey for: Bereth Hopkins  
 Section 8, Township 37 South, Range 2 West, Willamette Meridian,  
 Jackson County, Oregon.

Purpose of Survey:

To establish property lines.

Survey Procedure:

Found section corner at Northeast corner Section 8, Township 37 South Range 2 West, Willamette Meridian and bearing trees at North, East, South and West Quarter (1/4) section corners. Subdivided section and set 5/8 inch diameter iron pin at the Northeast sixteenth corner of Section 18. Set 5/8 inch diameter iron pin on North-South center section line, from which the Northeast sixteenth corner Section 18 bears East 1325.74 feet. Ran thence North  $0^{\circ} 48' 30''$  (var.  $20^{\circ}$  East) along said North-South centerline 347.65 feet and set one-half inch diameter iron pin. Ran thence South  $75^{\circ} 35' 20''$  East (var.  $20^{\circ}$  East) 41.11 feet. Set one-half inch diameter iron pin witness corner 10.00 feet north. Ran thence North  $73^{\circ} 12' 40''$  East (var.  $20^{\circ}$  East) 168.56 feet and set one-half inch diameter iron pin property corner; thence South  $86^{\circ} 29' 30''$  East (var.  $20^{\circ}$  East) 196.35 feet and set one-half inch diameter iron pin property corner; thence South  $68^{\circ} 59' 10''$  East (var.  $20^{\circ} 30'$  East) 190.40 feet and set one-half inch diameter iron pin property corner; thence South  $61^{\circ} 29'$  East (var.  $20^{\circ} 30'$  East) 146.45 feet and set one-half inch iron pin property corner; thence North  $88^{\circ} 44' 20''$  East (var.  $21^{\circ}$  East) and set one-half inch iron pin property corner; thence North  $52^{\circ} 18'$  East (var.  $21^{\circ} 30'$  East) 613.99 feet and set 5/8 inch iron pin property corner on the North-South sixteenth section line from which the Northeast center one-sixteenth corner and point of beginning bears South  $0^{\circ} 21' 40''$  East (var.  $21^{\circ} 30'$  East) 614.35 feet.

Bearings based on solar observations.

J. H. Clabby

January 1951

