


BOUNDARY LOCATION
PROPERTY SITUATE IN
DLC 39 T 36 S R2W AND
DLC 68 T 36 S R1W WM
JACKSON COUNTY OREGON

J H CLABBY CIVIL ENGINEER
MEDFORD OREGON 7 FEBRUARY 1951
SCALE 1" = 200'

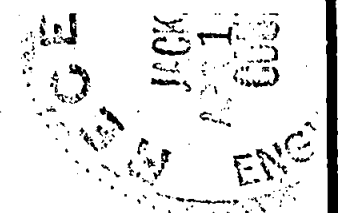

Survey Narrative to Comply with Section 87-330, 1947 Oregon State Laws.

Survey for: F. A. Rohl

D.L.C. No. 39, Twp. 36 South, Range 3 West and D.L.C. No. 68,
Township 36 South, Range 2 West, Willamette Meridian, Jackson
County, Oregon.

Purpose of Survey:

Establish property boundaries and corners.

Procedure: Found iron pipe set for corners on survey for L. J. Amer,
September 1949, Calculated position of point of beginning from this
survey. Found stone monument and scribed bearing tree at Southeast
corner of D. L. C. No. 68, Township 36 South, Range 2 West. East line
of said D. L. C. No. 68 was found to be South $0^{\circ} 03' 40''$ West instead
of record South. Ran from calculated point of beginning South $63^{\circ} 00'$
East 1431.10 feet to East line of D. L. C. No. 68, thence South $0^{\circ} 03'$
 $40''$ West along said East line 21.02 feet and set 1 inch iron pipe
witness corner on southerly right of way line of the Old Stage Road,
as determined by line of stakes marked right of way, continued thence
South $0^{\circ} 03' 40''$ West along D.L.C. line 590.89 feet and set 1 inch
iron pipe for property corner, thence North $64^{\circ} 53' 30''$ West 1109.63
feet and set $\frac{1}{2}$ inch iron pipe for corner of exception for spring, thence
North $41^{\circ} 02'$ West 286.03 feet and set $\frac{1}{2}$ inch iron pipe for corner of
exception for spring, thence North $82^{\circ} 17' 40''$ West 335.05 feet, thence
North $25^{\circ} 15'$ East 560.04 feet and set 1 inch iron pipe witness corner
on southerly right of way line of Old Stage Road, thence continued
North $25^{\circ} 15'$ East 26.09 feet to the point of beginning.

Bearings based on solar observations.

J. H. Clabby

February 1951

