

BOUNDARY LOCATION
PROPERTY SITUATE IN
D.L.C. NO. 43, T.38 S., R 1 W., W.M.
JACKSON COUNTY, OREGON.

CLABBY AND LOVEJOY MEDFORD, OREGON

APRIL 25, 1950

SCALE 1" = 50'



ALL BEARINGS DERIVED BY SOLAR OBSERVATION.

N.W. COR. D.L.C. 43

EAST
2877.58'

1681.39'

SOUTH

SET IRON PIN

SET IRON PIN

N 53° 17' 30" E
175.32'

S 31° 56' 30" E
272.68'

30'


HWY. NO. 99 (ORE. - U.S.)
N 36° 46' 30" W
2611.4'

FOUND IRON PIPE

S 57° 16' 00" W
152.72'

FENCE POST

30'

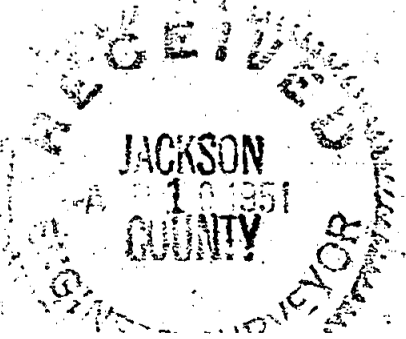

Survey Narrative to Comply with Section 87, 330, 1947 Oregon State Laws.

Survey for: C. F. Johnson
D. I. C. No. 43, Township 38 South, Range 1 West,
Willamette Meridian, Jackson County, Oregon

Purpose of survey:

To establish the property boundary.

Procedure: Found 1 1/2" galvanized iron pipe at northwest corner D. I. C. 43, said
pipe is near a fence corner. Set iron pins as shown on map.

Bearings by solar observation.

April 1950

J. H. Clabby

