

1" Iron Pin, Set 1947 by County for 1/4" Corner. Iron Pin, R.P. 30.03 to E Table Rock Road

N 1/2 Sec. 25 & Table Rock Road; R/W Laid from E of Road.

3/4 Point - 2.76

1/2 Point - 1.64

3/4 Point - 1.23

1/4 Point - 0.82

K.P.X. in Conc. Headwall 33.03 to 1/4 Cor.

Iron Pin for 1/4 Cor. R.P. 31.1 P. 30.03 to 1/4 Cor.


NOTE:-

County Survey had run and established the bearings on the East, North & West Lines. I checked the angles and distances closely & accepted them. I then run the South Line at S. 89° 42' E - 2649.7. The Traverse Closed, near. Distances shown are as measured or computed. No Survey was made, nor stakes set for Acreages in Sec. 36. All corners are Iron Pipe.

MEDFORD, JACKSON COUNTY, OREGON.

MAP - SHOWING Acreages in So. 1/2 of NW 1/4 of SEC. 25, TWP. 36 S., Rg. 2 W., W.M. Surveyed & Mapped Apr. 1951, for Dr. Grace Orr Harrison. SCALE 1"=200'

S.C. Watkins Consulting Engineer

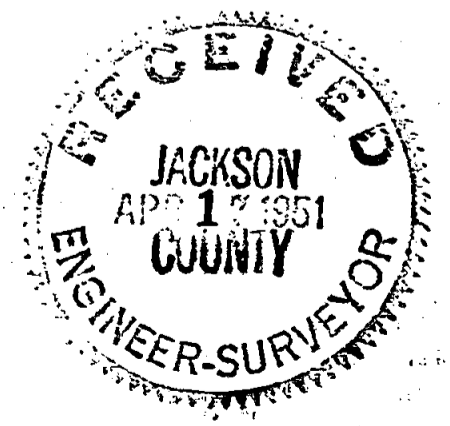

S. C. WATKINS

CONSULTING ENGINEER

GOLDY BUILDING

MEDFORD, OREGON

MUNICIPAL PROBLEMS
WATER AND SEWAGE
TREATMENT

April 16, 1951

Mr. Paul Ranning,
County Engineer
Medford, Oregon

Dear Sir:

Enclosed is a map showing certain acreage tracts in the South half of the South West Quarter of Section 25 Twp. 36 South, Range 2 West, T.M., which I have recently laid out and corner staked for Dr. Orr Harrison.

These acreages have been sold or contracted for sale during the past several years; but never been staked out before.

The corners established by the county were used or replaced and used. County distances were checked very closely and used, as were also the County bearings.

Yours very truly


S.C. Watkins

353

