


354


354

354

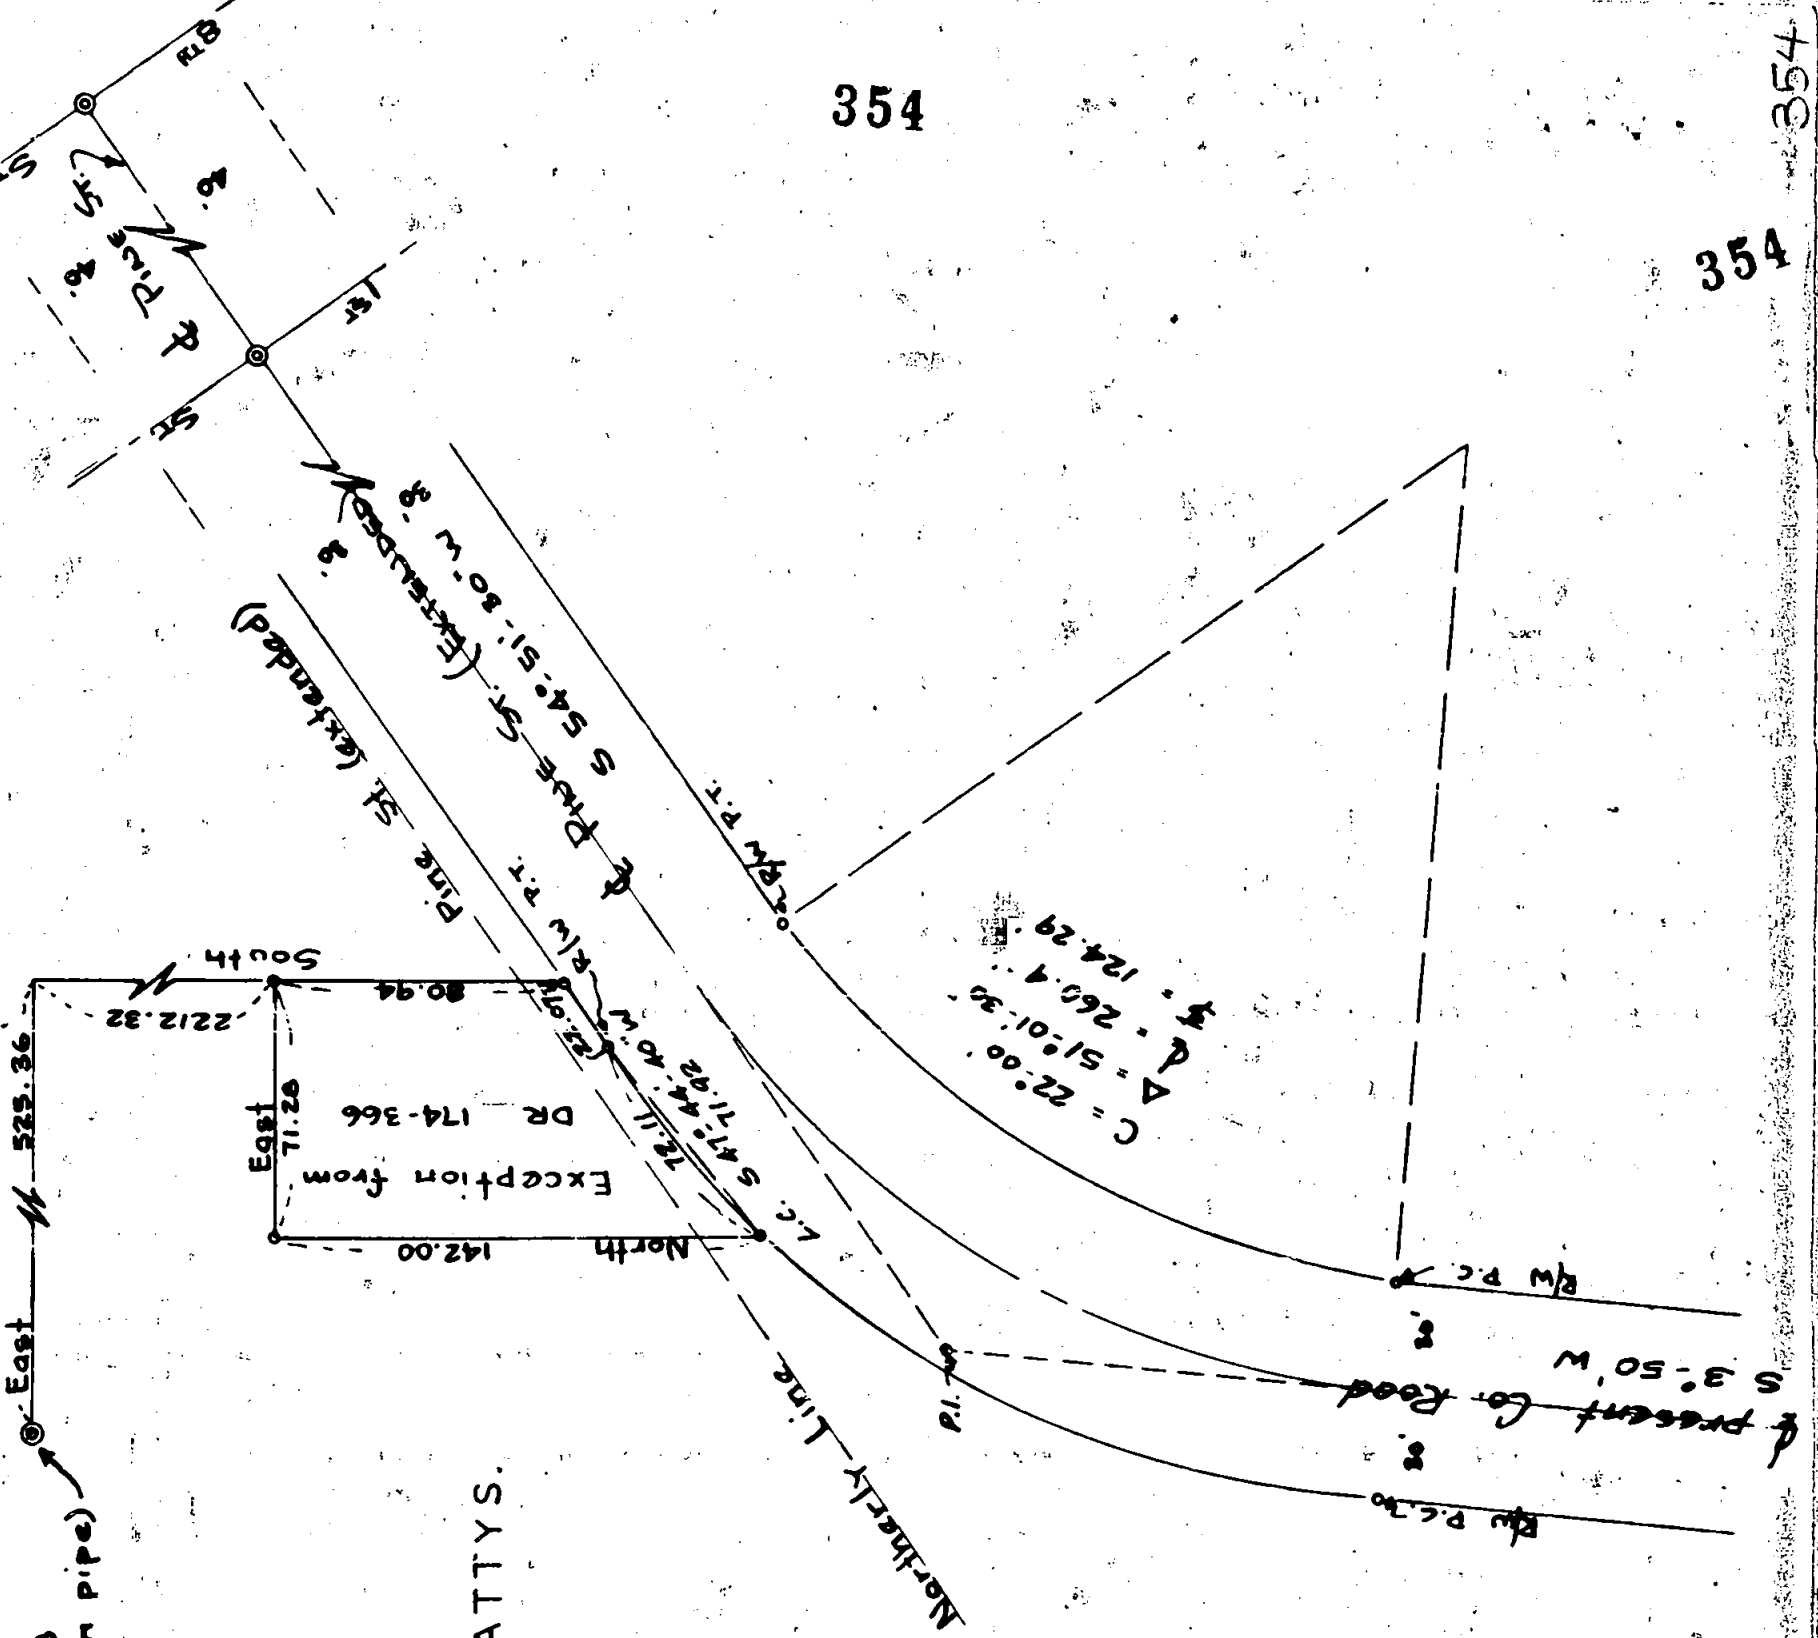

NW cor. D.L.C. #53
(1 1/2" galv. iron pipe)

SURVEY FOR
J. P. SEDLMAYR
 BY ORDER OF HEISEL & JONES, ATTSY.
 SEC. 10, T 37SR2W
 FEB. 1951.

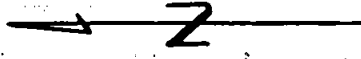

SCALE: 1"=60'

REGISTERED
OREGON
 LAND SURVEYOR
C. Z. Boyden
 MARCH 10, 1944
 C. Z. BOYDEN

RECEIVED CONTROL MONUMENT
JACKSON
 May 31, 1951
COUNTY
 ENGINEER-SURVEYOR
 IRON PIPE
 IRON PIN

354

Survey Narrative to comply with Section 87-330 Oregon State Law (1947).

Survey No. 354

For: J. P. Sedlmayr by order of Heisel & Jones, Attorneys

Purpose: To monument and describe the exception from that property described in Jackson County Deed Records--Volume 174, Page 366.

Procedure:

From the official reestablished NW corner of D.L.C. #53, Township 37 South, Range 2 West, ran deed record distances east and south for the point of beginning of said exception; thence ran west a record distance of 71.28 feet; thence ran south to the north-westerly boundary of the county road, as now located; thence ran along said roadboundary to a point south of the point of beginning; thence ran north to the point of beginning.

All distances, courses, and monuments are shown on the attached map.

February - 1951

REGISTERED
OREGON
LAND SURVEYOR

C. Z. Boyden

MARCH 10, 1951
C. Z. BOYDEN
7

RECEIVED
JACKSON
May 31, 1951
COUNTY
ENGINEER-SURVEYOR