

PACIFIC HIGHWAY No. 99
N 58°-20'-30" E

NEW COUNTY PROPOSED LOCATION
N 20°-24' W
632.68 ROAD

NE COR DLC #69

SOUTHERN

1/4 cor Sects 20 & 29

S 89°-55'-15" E
1206.32


2676.34

1/6 Sec. Cor. 20 21
29 28

SURVEY FOR
GOLD RAY REALTY CO.
SECTIONS 20 & 29 T36S R2W
MAR. 1951

MERIDIAN CONTROL: ROGUE BASE LINE

REGISTERED
OREGON
LAND SURVEYOR
C. Z. Boyden
C. Z. BOYDEN

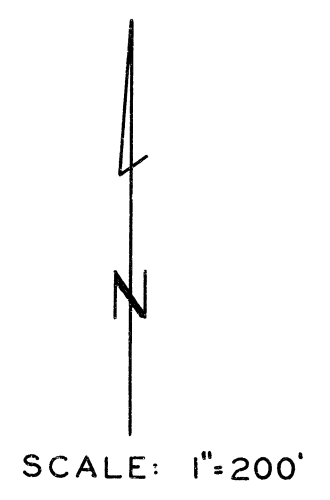

- ⊙ RE ESTABLISHED GOVERNMENT CORNER
- IRON PIN
- IRON PIPE

932.33
264.41
341.62
1324.54
1303.32
2956.62
2649.37
5 0°-07'-30" W
5 0°-12'-40" W
ROAD

Found
S 54°-38'-20" W
698.24
S 54°-51' W

PACIFIC N 35°-09' RAILROAD
1052.38

RLW

A = 38.1

Roadway Easement Sec DR 236-332
S 89°-55'-30" E 1180.09
South line of the North 1/2 of Govt. Lots 1 & 2, Sec. 29

E.S.E. COR DLC #69
Center Sec. 29

1/4 cor Sects 30 & 29

N 89°-55'-40" W

1339.47

1/4 cor Sects 29 & 28
1339.47

1/4 cor Sects 29 & 32

Survey No. 356

For: Gold Ray Realty Company

Purpose: To establish the relocation of a section of County Road across the northeast corner of D.L.C. No. 69, Township 36 South, Range 2 West, to the Pacific Highway. Also to establish the boundaries of that tract between this relocated Road and the present property of the Table Rock Lumber Company. Then established the boundaries of a tract of land south of the southerly line of the present property of the Table Rock Lumber Company, being the North $\frac{1}{2}$ of Government Lots 1 and 2 of Section 29 and the southerly portion of D.L.C. No. 70.

Procedure: Established the east boundary of D.L.C. No. 69 and subdivided Section 29 to establish the boundaries of said lots 1 and 2 and then established the south line of the north $\frac{1}{2}$ of these lots.

Established the relocated County Road as directed and the south-westerly right of way line of the S.P. Railroad 100.0 feet from the centerline.

Since the point of beginning of the Table Rock Lumber Company tract was the only boundary monument found on said tract the boundaries were established as near as possible to agree with the record description.

All boundaries surveyed and monumented are shown on the map to accompany this report. A strip of land 30.0 feet wide along the easterly boundary of D.L.C. 69 was excluded from the description since it is now occupied as a County Road.

April, 1951.

REGISTERED
OREGON
LAND SURVEYOR

C. Z. Boyden

MARCH 10, 1951
C. Z. BOYDEN

7

May 24, 1951

REGISTERED
LAND SURVEYOR