


SURVEY FOR  
**E. R. YOCOM**  
 LOCATED IN CENTRAL POINT  
 SEC. 10 T 37 S R 2 W  
 FEB. 1951

REC. FRED  
**OREGON**  
 LAND SURVEYOR

MARCH 10, 1951  
 C. Z. BOYDEN

- ⊙ CONTROL MONUMENT
- IRON PIPE

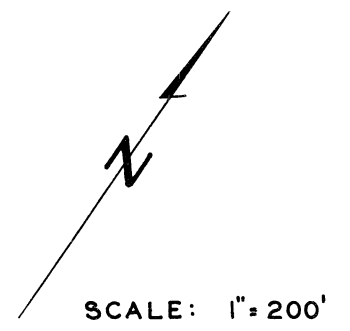

SE cor DLC #53  
 (1/2" galv. iron pipe)

Section 10, Township 37 South, Range 2 West, Willamette Meridia **358**

Survey No. 358

For: E. R. Yocom

Purpose: To establish the boundaries of Lot A, of Cooksey Addition to Central Point and then establish the boundaries of tracts therein as directed.

Procedure: Established the south line of Cooksey Addition along the north line of D.L.C. No. 54 between the reestablished corners on said line. Then established the line of Pine Street from the street center line monuments and extended said line southwesterly to an intersection with the north line of said D.L.C. No. 54. The easterly line of tract A. was established parallel to and 660.0 feet from the southwesterly right of way line of the Southern Pacific Railroad.

Since the existing old fence between tracts A and B has been the accepted division line for many years, it was agreed by the two adjoining owners to establish the division line along said fence line.

From the above mentioned controls the boundaries of Lot A were surveyed and monumented and the tracts staked as shown on the map to accompany this report.

February - 1951

REGISTERED  
OREGON  
LAND SURVEYOR

*C. Z. Boyden*  
MARCH 10, 1944  
C. Z. BOYDEN  
7

JUN 22, 1951