
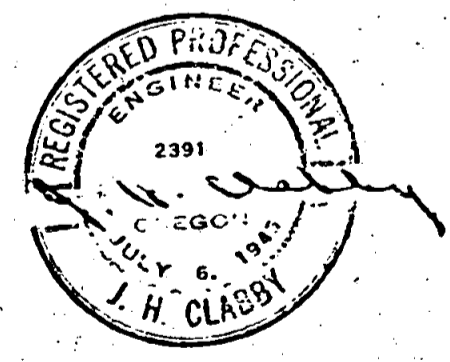


NOTE:
 BASIS OF BEARINGS- U.S.E.D. DATA, AND WHITE CITY SURVEY
 BY C.Z. BOYDEN, JACKSON COUNTY SURVEYOR, DATED NOV 1948

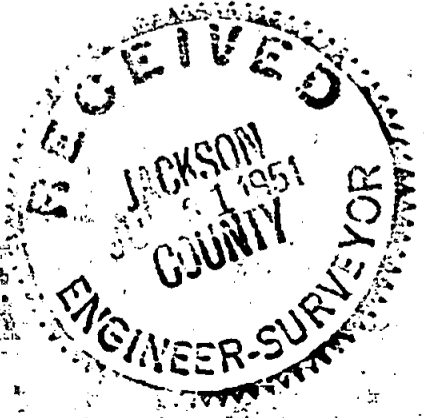

**SUBDIVISION OF SECTION 17
 T. 36 S., R. 1 W., WILLAMETTE MERIDIAN
 JACKSON COUNTY, OREGON**

**JAMES H. CLABBY, CIVIL ENGINEER
 MEDFORD, OREGON
 OCTOBER 5, 1949
 SCALE: 1" = 500'**

WHITE CITY

Survey Narrative to Comply with Section 87-330, 1947 Oregon State Laws.

Survey for: White City Lumber Company
White City, Oregon

Purpose of Survey:

To subdivide section 17, Township 36 South, Range 1 West, Willamette Meridian, Jackson County, Oregon.

Survey Procedure:

Found southeast corner, southwest corner and northwest corner Section 17, and northeast corner Section 15, said township and range. Subdivided section accordingly.

J. H. Clabby

October 1949

