


NW CORNER
EDMONDS SUBDIV.

BOUNDARY LOCATION
PROPERTY SITUATE IN
NW 1/4 SEC. 14 T 39 S R 1 E WM
JACKSON COUNTY OREGON

J H CLABBY
MEDFORD OREGON
CIVIL ENGINEER
19 MAY 1951

SCALE 1" = 100'

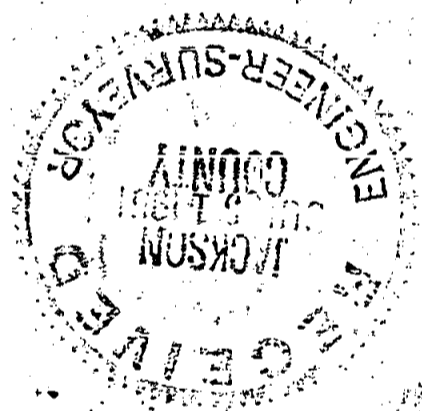

CLAY ST

Survey Narrative to Comply with Sec. 87-330, 1947 Oregon State Laws.

Survey for: C. W. Smith
Clay Street, Ashland, Oregon

Purpose of Survey:

Survey of $\frac{1}{2}$ acre parcel of land from a 5-acre tract.

Survey Procedure:

Found northwest corner of Edmunds Subdivision. Established record bearings and ran traverse through property locating existing property lines and two pipe monuments on southerly boundary.

Staked and described the one-half acre parcel accordingly.

J. H. Clabby

May 1951

