

SURVEY FOR
E. E. NILL

ORIGINAL TOWN - CENTRAL POINT, ORE.

JUNE 1951

LAUREL ST.

N 54° 51' 20" E 275.72

PINE ST.

OFFICIAL CITY STREET MONUMENT

IRON PIN

SCALE:
1" = 60'

ENGRS. & U.S. HIGHWAY NO. 99

FRONT ST.

380.30

15

380.36

FIRST ST.

180.34

12

60.35

13

180.34

275.68

OAK ST.

REGISTERED
OREGON
LAND SURVEYOR

C. Z. Boyden

MARCH 10, 1944
C. Z. BOYDEN
7

CEDAR ST.

Survey No. 372

For: E. E. Nill, Central Point, Oregon.

Purpose: To establish the boundaries of Lots 12 and 13 of Block No. 15, of the original town of Central Point.

Procedure:


Established the centerline of Front Street between the monuments of Cedar and Laurel Streets then intersected this line with the centerlines of Pine and Oak Streets. Then traversed the street centerlines inclosing the block and established the lot boundaries by a direct proportion between plat record and measured distances.

Monuments set as shown on the map to accompany this report.

August - 1951



C. Z. Boyden

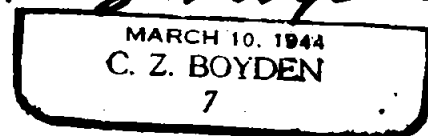

Survey No. 372

For: E. E. Nill, Central Point, Oregon.

Purpose: To establish the boundaries of Lots 12 and 13 of Block No. 15, of the original town of Central Point.

Procedure:

Established the centerline of Front Street between the monuments of Cedar and Laurel Streets then intersected this line with the centerlines of Pine and Oak Streets. Then traversed the street centerlines inclosing the block and established the lot boundaries by a direct proportion between plat record and measured distances.

Monuments set as shown on the map to accompany this report.

August - 1951



C. Z. Boyden

