



379

BOUNDARY LOCATION PROPERTY SITUATE IN DLC 50 T38S R2W WM JACKSON COUNTY OREGON

J H CLABBY
MEDFORD OREGON

CIVIL ENGINEER
18 JULY 1951

SCALE 1" = 100'

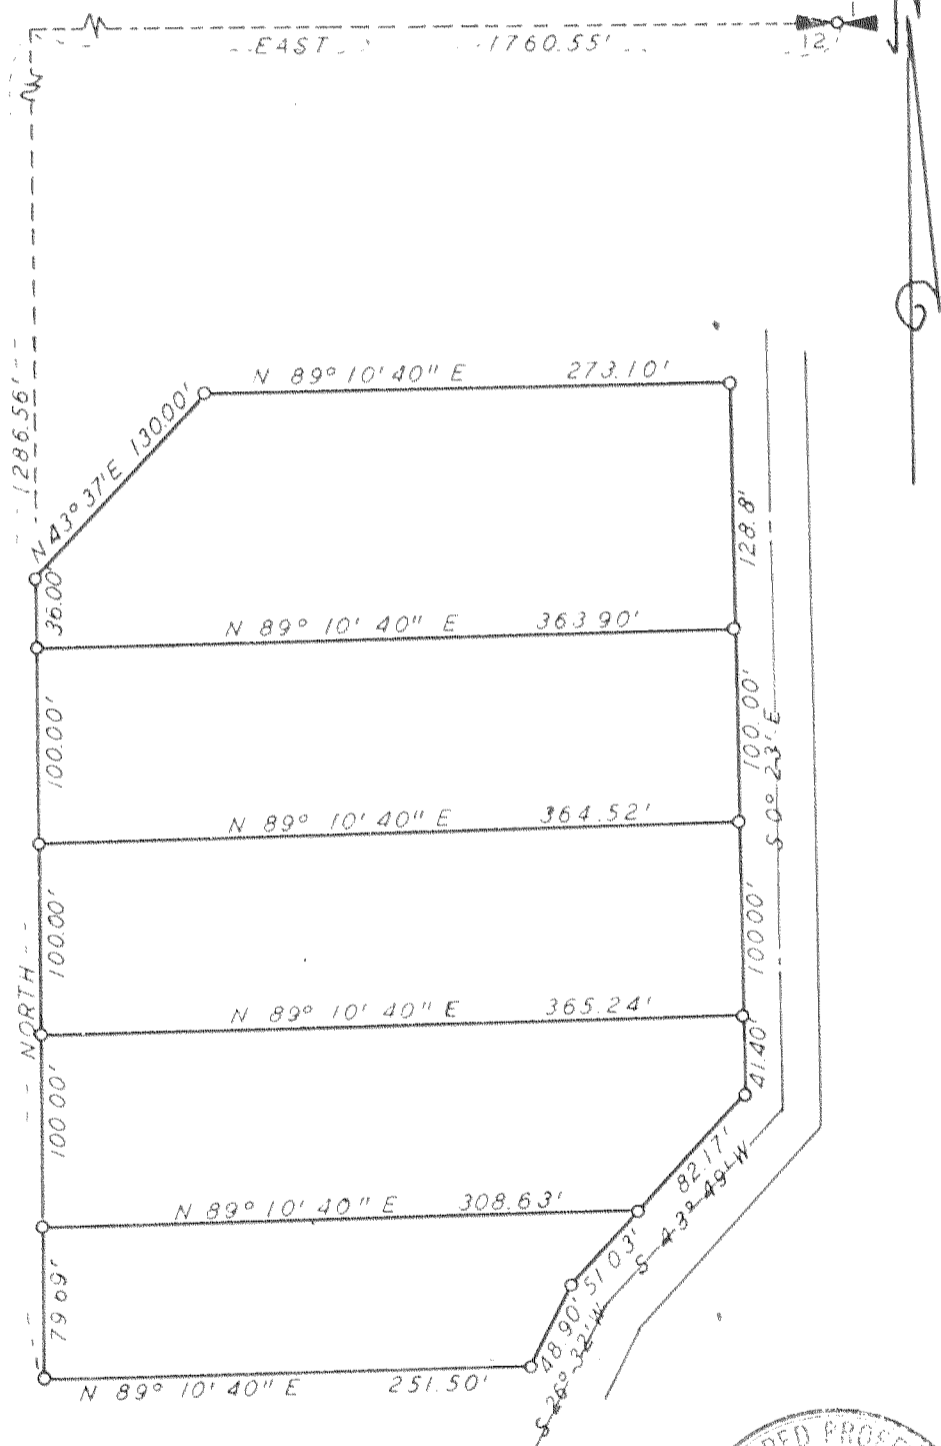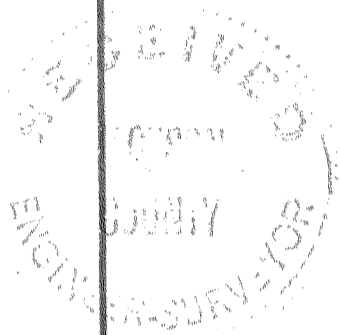

IRON PIPE AT ALL CORNERS

