


**SURVEY OF  
CHAMBERLAIN PROPERTY**  
 D.L.C. #44, T. 365. R. 1 W.  
 and  
 D.L.C. #40 T. 355. R. 1 W.  
 Jackson County, Oregon.  
 Scale 1" = 400' Hugh C. Ingle  
 Jan, 25, 1950 Civil Engineer

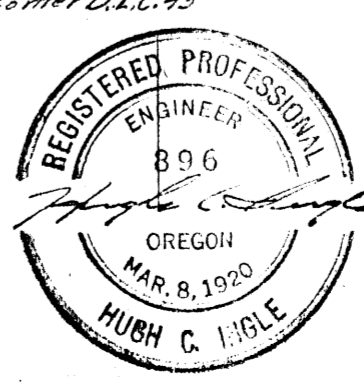

Found Stone With X  
 N.W. Corner  
 D.L.C. #39

Set 1" Pipe  
 2 1/2" W.P.  
 For N.E. Corner of  
 D.L.C. #40

D. L. C. #39

N. 0° 01' E. 2671.94'  
 (2653.2' Record)

Found 1" Iron Pin  
 S.W. Corner  
 D.L.C. #39

CREEK

Found 1" Pipe  
 S.E. Corner  
 D.L.C. #44

Found 1" Pipe  
 S.E. Corner  
 D.L.C. #44

Section  
 34 35  
 2

(3135.0' Record)  
 Found 4" Pipe Mon.  
 N.E. Corner D.L.C. #45

East 5310.66'  
 (5280.0' Record)

D.L.C. #45

(2145.0' Record) D.L.C. #44  
 2157.0' Proportioned

T. 365. R. 1 W.

T. 355. R. 1 W.

GREB

CHAMBERLAIN

(5280.0' Record)  
 N. 89° 57' 40" W. 5321.00'

3159.6' Proportioned  
 (3135.0' Record)




2161.4' Proportioned  
 (2145.0' Record)

5.0° 11' 40" E. 2670.58'  
 (2640.0' Record)

Set 1" Pipe  
 Find Stump and Stump Hole  
 Corresponding to 1875

Set 1" Pipe  
 For N.W. Corner of  
 Chamberlain

Existing Fence  
 5.0° 07' E.  
 2671.08'

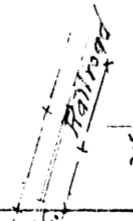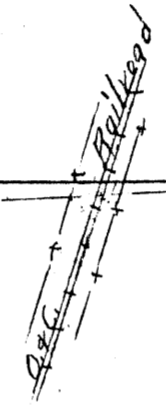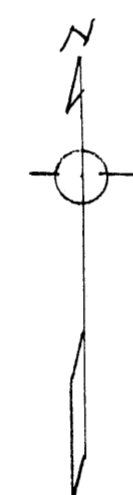

30' Easement  
 S.W. Corner Chamberlain  
 Set 1" Pipe 30' North  
 of D.L.C. Line

Found 1" Iron Pin  
 S.W. Corner  
 D.L.C. #44

NARRATIVE REPORT  
SURVEY

*Sec. 24 & 3*

D. L. C. #44 in T. 36 S. R. 1 W. W. M.  
and

D. L. C. #40 in T. 35 S. R. 1 W. W. M.

*Sec. 34 & 35*

JACKSON COUNTY, OREGON

**PURPOSE:**

The purpose of this survey was for running boundaries and corners of the Donation Land Claims involved and to establish the divisions of two ownerships.

**PROCEDURE:**

Restablished corners of the South line of Donation Land Claim #44 and the Northeast corner of Donation Land Claim #40 were found and evidence of one bearing tree stump and a stump hole corresponding to call of the notes were found for the Northwest corner of Donation Land Claim #40, from which the temporary Northwest corner of Donation Land Claim #40 was set. Lines were run between those corners which form the land boundary.

Distances between the Donation Land Claim corners were all in excess of the record distances, as explained on the plat. Division of ownership was determined by proportioning length of the North and South boundaries, and division corners were set accordingly. Bearings were made from record highway bearings between monuments to maintain consistency.

