



Note: Acreages shown above have been calculated to the \pm of Wilson Road

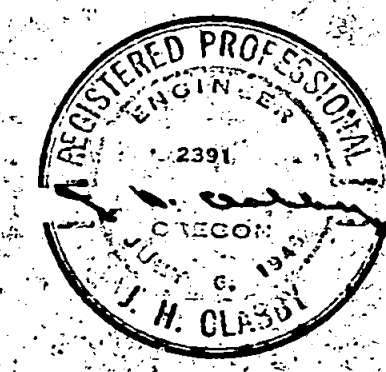

BOUNDARY LOCATION
 PROPERTY SITUATE IN
 SECTION 36, T36S, R2W, W.M.
 JACKSON COUNTY, ORE.
 J.H. CLABBY, CIVIL ENGINEER
 MEDFORD, OREGON
 SCALE - 1" = 50' Nov. 1, 1951

 

#412

Survey Narrative to Comply with Section 87-330, 1947 Oregon State Laws.

Survey for: Ralph Harger

Location: Section 36, Township 36 South, Range 2 West Willamette, Jackson County, Oregon.

Purpose: To locate five parcels of land in property described in Deed Record 306-121 in Section 36, Township 36 South, Range 2 West, WM.

Survey Procedure:

Found quarter corner common to Sections 35 and 36, said township and range. Also found iron pipe at center of section 36.

Commencing at quarter corner ran South $89^{\circ} 51' 30''$ East 348.00 feet and North $0^{\circ} 08' 30''$ East 30.00 feet to the North line of Wilson Road for point of beginning. From this point the following parcels were located to the north and east:

2 - 1-acre parcels 300.00 feet north and south and 132.00 feet east and west,

1 - 0.69 acre parcel, 300.00 feet north and south by 180.00 feet east and west,

2 - 2-acre parcels 300.00 feet north and south by 264.00 feet east and west.

J. H. Clabby

October 1951

