


SURVEY FOR  
**VICTOR NOEL**  
 ORIGINAL TOWN

CENTRAL POINT ORE.  
 APR. 1952

REGISTERED  
**OREGON**  
 LAND SURVEYOR

MARCH 10, 1944  
**C. Z. BOYDEN**  
 7

443

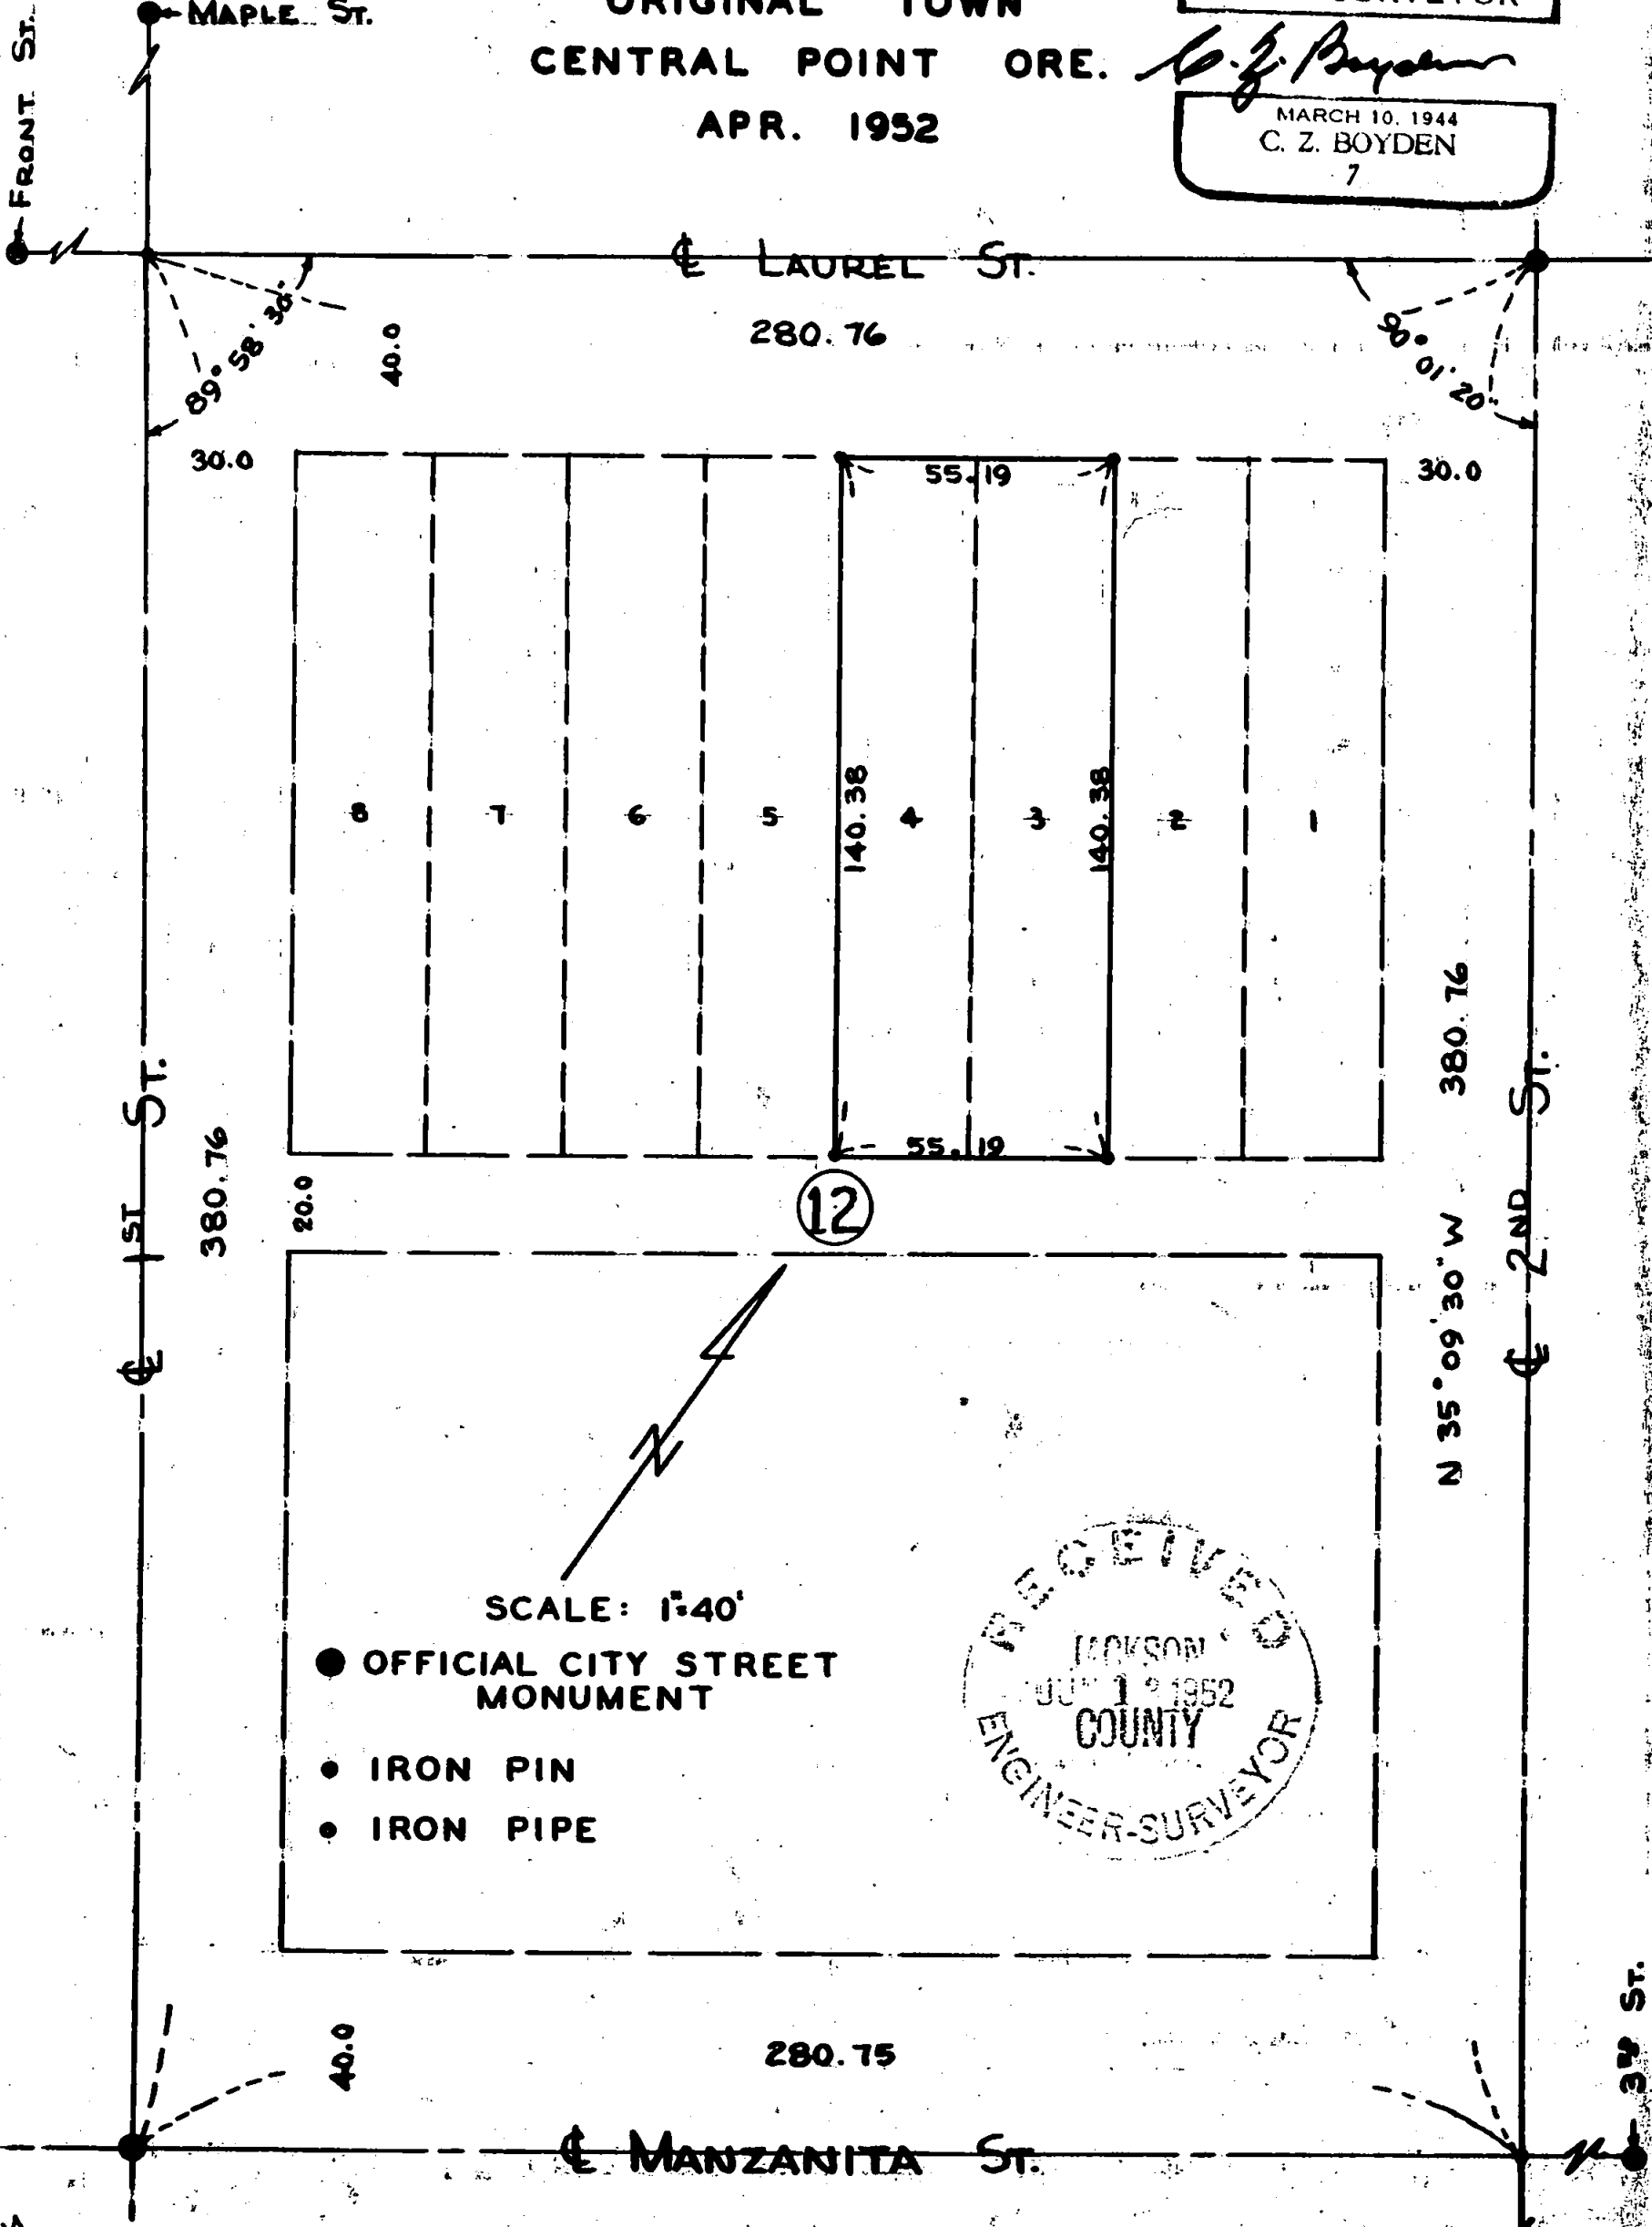

677

15 AC 30 ST.

Survey Narrative to Comply with Section 87-330 O.C.L.A.

Survey No. ~~—~~443

For: Victor Noel

Purpose: To re-establish and monument the outside boundary of lots 3 and 4, Block 12 in the original town (now city) of Central Point, Oregon.

Procedure: Traversed the street centerlines surrounding said Block 12, using the official city street centerline monuments and cut-in street intersections as shown on the attached plat.

Monumented the corners of said outside boundary with 1/2" x 24" iron pins on proportionate measurement.

April 1952



*C. Z. Boyden*

