

879
1716

N. 89° 25' E. 754.80'

452

N. 0° 13' W.

1138.53'


S. 19° 57' E.

1207.15'

S. 89° 26' W. 1162.65'

S.W. COR.
D.L.C. 44

BOUNDARY LOCATION
PROPERTY SITUATE IN
SEC. 16 T37S R2W WM
JACKSON COUNTY OREGON
JH CLABBY CIVIL ENGINEER
MEDFORD, OREGON DEC. 21, 1951
SCALE 1"=200'

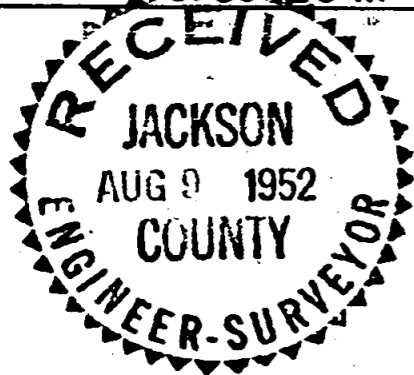

Survey Narrative to Comply with Section 87-330, 1947 Oregon State Laws.

Survey for: E. O. Reinking

Location: Northwest Quarter of Section 16, Township 37 South, Range 2 West,
Willamette Meridian, Jackson County, Oregon.

Purpose of Survey:

To survey a 25 acre tract.

Procedure:

Found Section corner common to Sections 8,9,16 and 17, said township and range. Accepted bearings and distances for west line of property as established during April 1949 by J. A. Hoffbuhr, a registered surveyor. From said Section corner North 89° 25' East 754.8 feet along the north section line, to a designated point on the westerly bank of the Medford Irrigation District canal.

Using previous survey, mentioned above, for the westerly line of the property as South 0° 13' East 1138.53 feet, the easterly and southerly lines were computed and the property was staked accordingly.

J. H. Clabby

December 1951

