

1/4 SECTION CORNER


16
15

S. 695.33'

W. 576.10'

62.00'

N. 88° 31' 258.00'

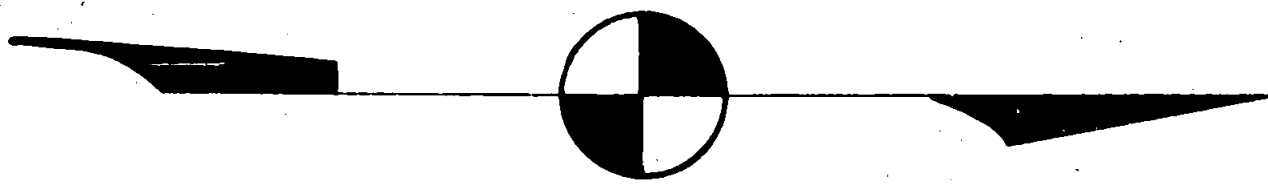

COUNTY ROAD

N. 1° 29' W. 163.04'

N. 88° 31' E. 110.05'

N. 1° 46' W. 551.27'

S. 77° 42' W. 224.69'

S. 24° 31' E. 211.80'

S. 74° 17' N. 122.60'

S. 42° 57' W. 155.16'

S. 1° 29' E. 336.28'

453

BOUNDARY LOCATION
PROPERTY SITUATED IN
SEC. 15 T34S RIW WM
JACKSON CO. OREGON

J.H. CLABBY CIVIL ENGINEER
MEDFORD, OREGON
JANUARY 14, 1952

SCALE 1" = 50'

- PIPE FOUND
- PIPE SET



Survey Narrative to Comply with Section 87-330, 1947 Oregon State Laws.

Survey for: Jesse Miller

Location: Section 15, Township 34 South, Range 1 West Willamette, Jackson County, Oregon.

Purpose of Survey:

To survey an irregular parcel of land for sale purposes.

Procedure: Found quarter corner common to Sections 15 and 16, said township and range. Also found points established on previous surveys. From the available points the parcel was located and described for points designated by the owner's representative.

January 1952

J. H. Clabby

