


**SURVEY OF M. & B. PROPERTY for L.G. MORTHLAND
 IN BLOCK 4
 EXTENSION OF SISKIYOU HEIGHTS ADDITION
 SURVEY JULY 26, 1952 Bearings from record descriptions**

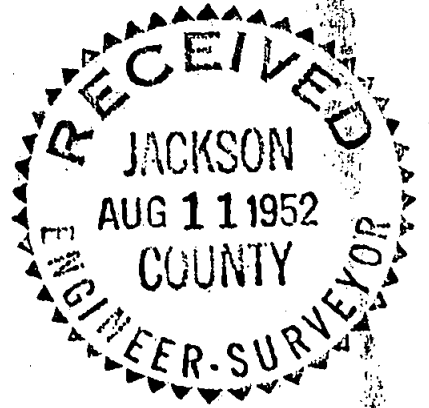

EAST MAIN ST.

East found 1" LPipe
 100'
 found 1/2" LPipe

S 7° 28' E 316.1

REGISTERED
OREGON
 LAND SURVEYOR
L. N. Dow.
 MAY 6, 1948
 L. N. DOW
 251

R 1081.3

SCALE 1" = 100'

AVE
 Chd. S 0° 21' 1/2" W - 294.43
 L 295.4

**BLOCK 4 EXTENSION OF
 SISKIYOU HEIGHTS ADD.**

AVE
 MODOC

BLOCK 5

R 1081.3
 L 40.58
 Chd N 8° 57' E 40.57

WINDSOR

East 288.5

3/4" LP found

West 155.04
 N 0° 01' E 34.63

N 89° 59' W
 120.00

S 14° 51' W
 117.71

1" LP found

1" S.E. Cor. B 5 found

507.2

S.W. Cor. B 5 temp. point.

1/8" LP (loose)

1" LP with plug & tack found

Solid circles indicate 5/8" x 30" Iron Bars set

455

455

Written narrative to accompany plat for survey No. _____
as specified by Oregon Law.

Survey for L.G. Northland, Medford, Oregon.

Date of survey July 26, 1952.

Purpose, to stake out parcel and prepare description
for sale purposes.

Procedure, Found beginning point of original deed, the
1/2" iron pipe at the Northwest corner of Block 4 Extension of
Siskiyou heights Addition, found the I. Pipe at the Southeast
corner of Block 5 and a 1" pipe with plug and tack at a point
on the east right of way of Modoc Avenue south of the South
line of Block 5, I then established the Southwest corner of
Block 5 and ran westerly to a point on the west side of Modoc
Avenue thence N 14° 51'E along the westerly side of Modoc
Avenue to a 3/4" iron pipe a distance of 77.17 feet which
point is at the corner of fence and checks deed ties to the
south line of Block 5. With this check closure I then set
5/8" x 30" iron pins for the remaining corners as shown on
the plat.

