
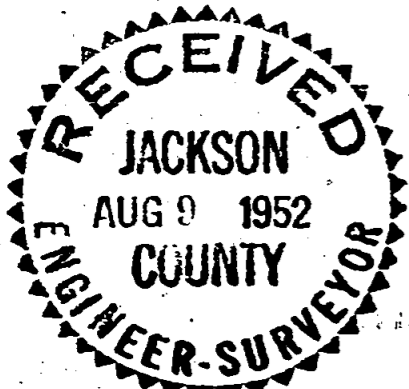


BOUNDARY LOCATION
PROPERTY SITUATE IN
D.L.C. 45 TWP 37S R2W WM
JACKSON COUNTY OREGON
JH CLABBY CIVIL ENGINEER
MEDFORD, OREGON DEC. 28, 1951

STONE MONUMENT
SE. COR. D.L.C. 45
T37S R2W WM

SCALE 1" = 200'

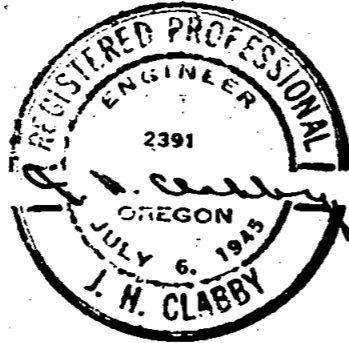

456

Also: Sec 9, T. 37 S., R. 2 W.

Survey Narrative to Comply with Section 87-330, 1947 Oregon State Laws.

Salade

Survey for: L. A. Saladay

Location: Southeast corner D.L.C. No. 45, Township 37 South, Range 2 West, Willamette Meridian, Jackson County, Oregon.

Purpose: To survey an 18-acre tract.

Procedure: Located a stone monument which is accepted as the southeast corner of D. L. C. No. 45, said township and range. From said corner, using bearings from a previous survey, the fence lines were accepted for the East and South lines of D.L.C. No. 45. An 18.791 more or less acre parcel was surveyed with an existing fence for the north boundary.

J. H. Clabby

December 1951

