

Northwest Corner,  
D.L.C. #50

457

BOUNDARY LOCATION


PROPERTY SITUATED IN D.L.C. #38  
T38S, R2W, W.M.

JACKSON COUNTY, OREGON

J.H. CLABBY - CIVIL ENGINEER  
MEDFORD, OREGON

SCALE: 1" = 30'

FEB. 11, 1952

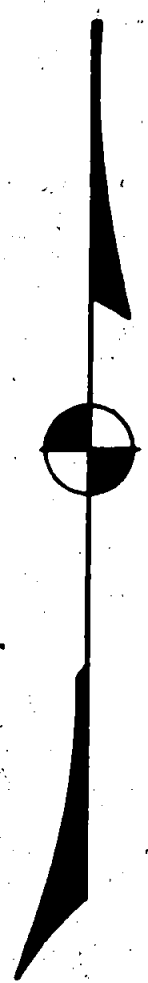

South - 885.06'

S00° 22' E - 189.00'

S89° 50' W - 150.27'

S01° 53' W - 29.76'

N89° 25' W - 77.27'


N00° 12' W - 60.00'

N00° 12' W - 157.87'

East - 2916.89'

Point of Beginning

N89° 51' 30" W - 228.07'

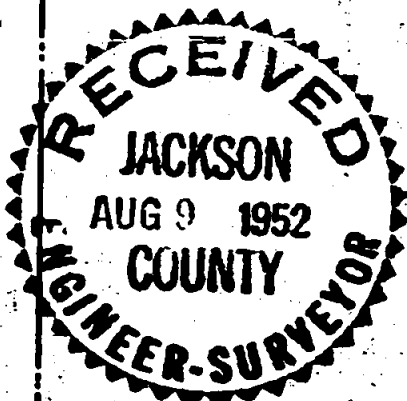

## Survey Narrative to Comply with Section 87-330, 1947 Oregon Laws.

Survey for: Jim Elliott

D.L.C. No 38, Township 38 South, Range 2 West, Willamette Meridian  
Jackson County, Oregon.

Purpose: To survey 1.046 acre tract in D.L.C. 38, said township and range, which is a fractional portion of Deed Record Volume 311, page 57 of Jackson County, Oregon.

Procedure: Found pipe monument corners for said Deed Record 311-57 and from said monuments the intermediate corners were located as designated by the owner.

The property description for Deed Record 311-57 was tied to the Northeast corner of D.L.C.No. 50 said township and range which could not be found and the northwest corner of said D.L.C. No. 50 and the initial point of the Kirkville Subdivision were used in lieu thereof.

February 1952

J. H. Clabby

