


Description bearings based on Record

Note: 5/8" Iron Pins set at Lot corners, except as designated otherwise.

458
BOUNDARY LOCATION

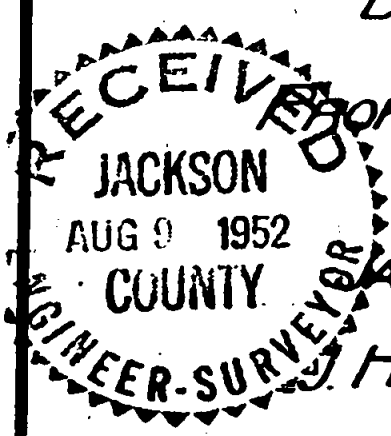

PROPERTY SITUATED IN SEC. 15,
T34S, R1W, W.M.,
JACKSON COUNTY, OREGON
J. H. CLABBY - CIVIL ENGINEER
MEDFORD, OREGON



SCALE: 1" = 20' FEB. 13, 1952

Survey Narrative to Comply with Section 87-330, 1947 Oregon State Laws.

Survey for: Page Estate

Location: Shady Cove Unrecorded Subdivision, Shady Cove, Jackson County, Oregon.

Purpose of Survey:

To survey and describe Lots 7 and 8, Block 7 of the Shady Cove unrecorded Subdivision.

Procedure: Found 3/4" iron pipe at the northeast and southeast corners of Lot 8.

The record distance between these points is 120.00 feet while the chained distance is 118.49 feet.

Ran traverse from northeast corner of Lot 8 to quarter corner common to Sections 15 and 22, Township 34 South, Range 1 West, Willamette Meridian, using record bearings.

Staked and described lot in accordance with record description except for minor changes in bearings and distances.

J. H. Clabby



February 1952

