

459

N.E. Cor.
D.L.C.81

NORTH 4799.47'
E County Road



EAST 396.39'

P.O.B. 30°

N. 0° 23' E.
164.27'

164.59'
S. 0° 50' E.

N. 89° 58' W. 399.87'

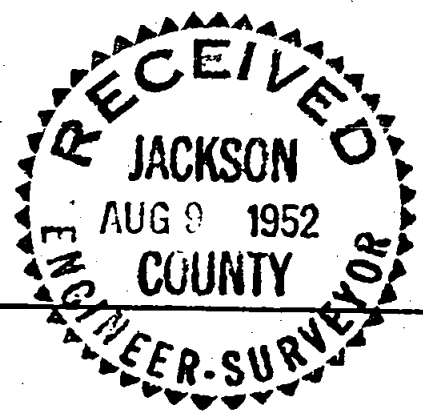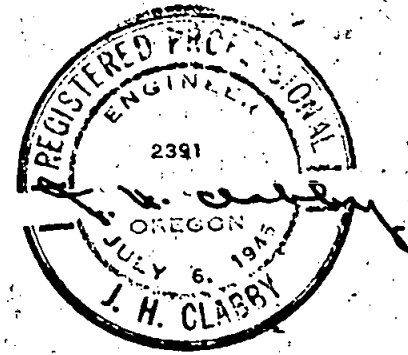

BOUNDARY LOCATION
PROPERTY SITUATE IN
Sec. 14 T. 38 S. R. 1 W. W. M.
JACKSON CO., OREGON
J. H. CLABBY CIVIL ENGINEER
MEDFORD OREGON JULY 14, 1952

SCALE 1" = 50'

Survey Narrative to Comply with Section 87-330, 1947 Oregon State Laws.

Survey for: Archie Fern

Section 14, Township 38 South, Range 1 West Willamette Meridian
Jackson County, Oregon

Purpose of Survey:

To locate and describe a 1.5 more or less acre parcel of land situate in Section 14, Township 38 South, R 1 WWM, Jackson County, Oregon.

Procedure: Found Northeast corner D.L.C.No. 81, said township and range. Found iron pipe monument on westerly right of way line of County Road at points 1723.08 feet and 2445.08 feet southerly from said D.L.C. corner. Offset 30 feet east from pipe monuments and established east D.L.C. line. Projected line south 2354.65 feet and west 30.00 feet for true point of beginning. From point of beginning staked as follows:

South 0° 50' East	164.59 feet,
North 89° 58' West	399.87 "
North 0° 23' East	164.27 "
East	396.39 "

Record bearings were used.

