


PROPERTY SITUATE IN
D.L.C. 66, T. 37 S. R. 1 W. W.M.
JACKSON COUNTY OREGON

L.P. LOVEJOY LAND SURVEYOR
MEDFORD, OREGON 19 MAY 1952

SCALE 1" = 100'

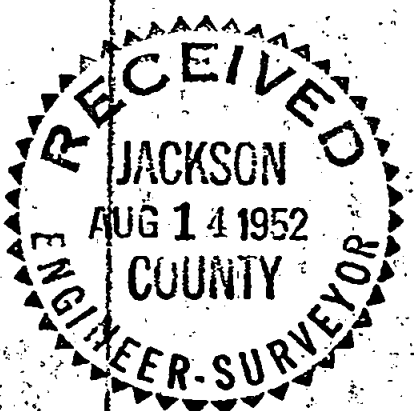

Survey Narrative to Comply with Section 87-330

1947 Oregon State Laws

Survey for: Mrs. Eva Garrett
Foothill Road
Medford, Oregon

Purpose of Survey: To run out boundaries of property to be sold.

Survey Location: D.L.C. 66, Township 37 South, Range 1 West,
Willamette Meridian, Jackson County, Oregon.

Survey Procedure: Ran out property boundaries and set 1" iron
pipe as shown on map. Found monuments indicated
and used record bearings.

Leland P. Lovejoy, Registered Land Surveyor

Work completed June 2, 1952

