


○ INDICATES IRON PIPE  
 ● INDICATES IRON PIN  
 BEARINGS BASED ON HWY  
 DEPT RECORDS

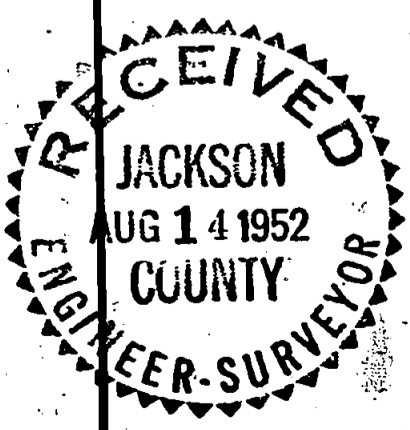

PROPERTY SITUATE IN  
 SECS 6 & 7 T 37 S R 1 W WM  
 JACKSON COUNTY OREGON  
 L P LOVEJOY LAND SURVEYOR  
 MEDFORD OREGON 15 MAY 1952  
 SCALE 1" = 200'

Survey Narrative to Comply with Section 87-3301947 Oregon State Laws

Survey for: Mr. Allison Moulton  
Medford, Oregon

Purpose of Survey: To run out boundaries of property to be sold.

Survey Location: Sections 6 and 7, Township 37 South, Range 1 West,  
Willamette Meridian, Jackson County, Oregon.

Survey Procedure: Found monuments as indicated on map. Ran out property boundaries and set 3/4" and 1" iron pipe as shown on map.

Leland P. Lovejoy, Registered Land Surveyor

Work completed June 1, 1952

