



SE 1/4 OF SW 1/4  
 OF SE 1/4

SW 1/4 OF SE 1/4  
 OF SE 1/4

BOUNDARY LOCATION  
 PROPERTY SITUATE IN  
 SE 1/4 SEC 17 & NE 1/4 SEC 20  
 T 37 S R 2 W WM  
 JACKSON COUNTY OREGON

L P LOVEJOY LAND SURVEYOR  
 MEDFORD OREGON 31 JULY 1952

SCALE: 1" = 100'

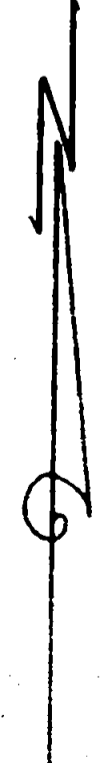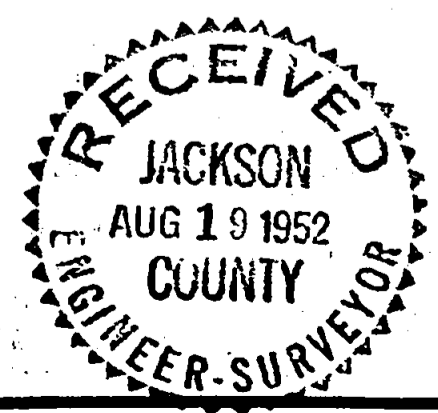

Survey Narrative to Comply with Section 87-3301947 Oregon State Laws

Survey for: Mr. John Rasmussen  
Ross Lane  
Medford, Oregon

Purpose of Survey: To run out boundary of property and divide into smaller tracts.

Survey Location: Southeast Quarter (1/4) of Section 17, and Northeast Quarter (1/4) Section 20, Township 37 South, Range 2 West, Willamette Meridian, Jackson County, Oregon.

Survey Procedure: Ran traverse and tied in roads, monuments, etc., shown on map, also other monuments not shown. Subdivided Southeast Quarter (1/4) of Section 17 accordingly, setting 3/4" and 1" iron pipe as shown. Bearings based on solar observations.

Leland P. Lovejoy, Registered Land Surveyor

Work completed July 31, 1952.

